


KANSAS

Russell

Sec. 19 Twp. 15 R. 13-WWell No. #4 Boomhower FarmTranswestern Company Ft. from N. Line330 Ft. from S. Line Ft. from E. Line330 Ft. from W. Line

Elev. 1879'.

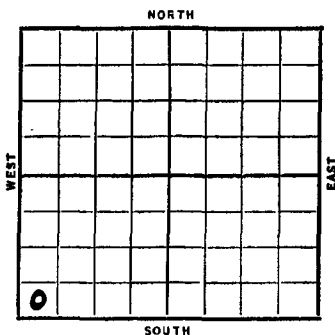

1938

4/20

7" @ 3324'.

Arb. 3323'.

T.D. 3346'.

3500 acid.

Potential 311 oil 3% water.

COMPLETED

Date	REPORT
1938	
1/19	R.R.
1/28	"
2/4	R.U.R.
2/11	S. H.
2/18	10" @ 600'. Drlg. 1240'.
2/26	Drlg. 2265'.
3/4	Drlg. 3218'.
3/11	Arb. 3323'. 7" @ 3324'.
	T.D. 3327'. S.O. RUST.
3/18	T.D. 3335'. 130' oil.
3/25	1500 acid. 1/2 bbl. oil P. H.
	S. D. O.
4/1	2000 acid. No help. S.D.O.
4/8	" " " " "
4/15	T.D. 3346'. Pump 90 oil & 25
	water in 6 hrs.
	OVER

Russell KANSAS

Map No. 73 Sec. 19 Twp. 15 R. 13WWell No. 4 Boomhower

Transwestern Company

Contractor

FIRST REPORT

SW/C

SECTION PLAT

0			

Ft. from N. Line

330 Ft. from S. Line

Ft. from E. Line

330 Ft. from W. Line

Location

Rig up

Drilling and Remarks:

RR

RECORD

Cased 7 in., 3324 ft.Sand Arb 332.3

Gas

Oil

Total Depth 3346

PRODUCTION

1st 24 hrs. Nat.

1st 24 hrs. after shot

Gas Cu. Ft.

Dry Hole

Abandoned

Date

JAN 19 1938

H. D. Hatfield

Scout

Russell KANSAS

Map No. 73 Sec. 19 Twp. 15 R. 13WWell No. 4 Boomhower

Transwestern Company

Contractor

COMPLETED

SW /C

SECTION PLAT

0			

Ft. from N. Line

330 Ft. from S. Line

Ft. from E. Line

330 Ft. from W. Line

Location

Rig up

Drilling and Remarks:

3500 acid

Pot 311 oil

3 7/8 qt

RECORD

Cased 7 in., 3324 ft.Sand Arb 332.3

Gas

Oil

Total Depth 3346

PRODUCTION

1st 24 hrs. Nat.

1st 24 hrs. after shot

Gas Cu. Ft.

Dry Hole

Abandoned

Date

APR 20 1938

19

H. D. Hatfield

Scout

Russell

KANSAS

Form 51-5M 5-37 Petrol

Section 19 Township 15 Range 13-W

Well No. 4 Boomhower

Company Transwestern

