

Russell KANSAS

Map No. _____ Sec. 19 Twp. 15 R. 13WWell No. 2 Sadie BoomhowerTranswestern etal Company

Contractor

FIRST REPORT

SW SE SW

Ft. from N. Line

330 Ft. from S. Line990 Ft. from E. Line

Ft. from W. Line

SECTION PLAT

	0		

Location _____

Rig up _____

Drilling and Remarks:

RR

RECORD

Cased _____ in., _____ ft.

Sand _____

Gas _____

Oil _____

Total Depth _____

PRODUCTION

1st 24 hrs. Nat. _____

1st 24 hrs. after shot _____

Gas _____ Cu. Ft.

Dry Hole _____

Abandoned _____

Date

OCT - 6 1937

19

H. D. Hatfield

Scout

Russell KANSAS

Map No. _____ Sec. 19 Twp. 15 R. 13WWell No. 2 Sadie BoomhowerTranswestern etal Company

Company

Contractor

COMPLETED

SW SE SW

Ft. from N. Line

330 Ft. from S. Line990 Ft. from E. Line

Ft. from W. Line

SECTION PLAT

	0		

Location _____

Rig up _____

Drilling and Remarks:

2000 Acid.

POT- 1183

RECORD

Cased 7 in., 3302 ft.Sand 511 3302

Gas _____

Oil _____

Total Depth 3304

PRODUCTION

1st 24 hrs. Nat. _____

1st 24 hrs. after shot _____

Gas _____ Cu. Ft.

Dry Hole _____

Abandoned _____

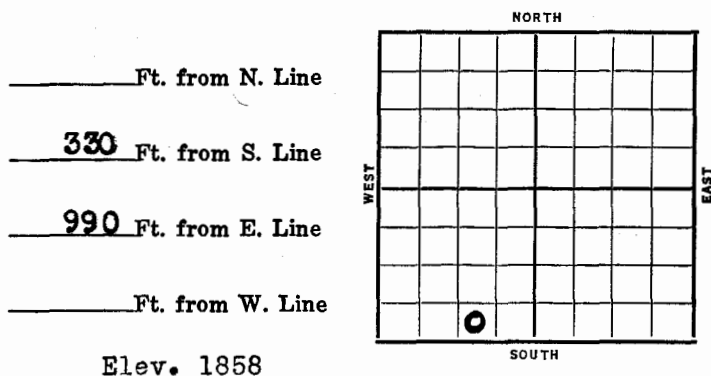
Date

NOV 3 1937

19

H. D. Hatfield

Scout

Sec. 19 Twp. 15 R. 13-WWell No. #2 Sadie Boomhower Farm
Transwestern et al Company

Date REPORT

1937**10/6** R. R.**10/15** 10" @ 600'. WOC.**10/22** Drilg. 2125'.**10/29** Sil. 3302'. T.D. 3304'.

7" @ 3302'. RUST.

No shows reported.

11/3 7" @ 3302'.

Sil. 3302'.

T.D. 3304'.

2000 acid.

Potential 1183 bbls.

COMPLETED

Russell**KANSAS**Section 19 Township 15 Range 13-WWell No. 2 Sadie BoomhowerCompany Transwestern et al