

KANSAS

Map No. _____ Sec. 19 Twp. 15 R. 13WWell No. 1-S. BoomhowerTranswestern etal Company

Contractor


FIRST REPORT

_____ Ft. from N. Line

330 Ft. from S. Line330 Ft. from E. Line

_____ Ft. from W. Line

SECTION PLAT

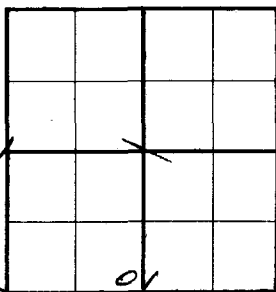

Location _____

Rig up _____

Drilling and Remarks:

R.R.

RECORD

Cased _____ in., _____ ft.

Sand _____

Gas _____

Oil _____

Total Depth _____

PRODUCTION

1st 24 hrs. Nat. _____

1st 24 hrs. after shot _____

Gas _____ Cu. Ft.

Dry Hole _____

Abandoned _____

Date

SEP 8 1937 19

H. D. Hatfield

Scout

Russell KANSAS

Map No. _____ Sec. 19 Twp. 15 R. 13WWell No. 1-S. BoomhowerTranswestern etal Company

Contractor

COMPLETED


SE SW

_____ Ft. from N. Line

330 Ft. from S. Line330 Ft. from E. Line

_____ Ft. from W. Line

SECTION PLAT

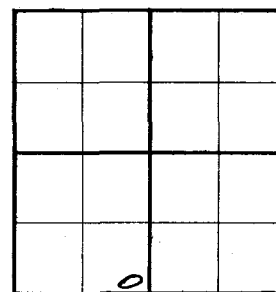

Location _____

Rig up _____

Drilling and Remarks:

1500 Acid
P- 20 1/4 & 20 1/4
POT-1209

RECORD

Cased 7 in., 3286 ft.Sand 511 3286

Gas _____

Oil _____

Total Depth 3288

PRODUCTION

1st 24 hrs. Nat. _____

1st 24 hrs. after shot _____

Gas _____ Cu. Ft.

Dry Hole _____

Abandoned _____

Date

OCT 20 1937 19

H. D. Hatfield Scout


Sec. 19 Twp. 15 R. 13-WWell No. #1 S. Boomhower FarmTranswestern et al Company

Ft. from N. Line

330 Ft. from S. Line330 Ft. from E. Line

Ft. from W. Line

Elev. 1848

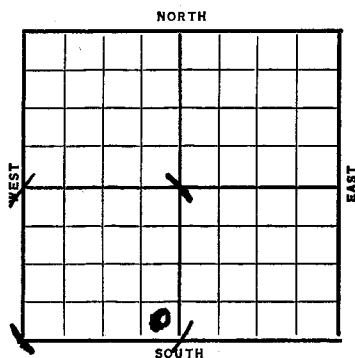

Date REPORT

1937

9/8 R. R.

9/17 10" @ 298'. WOC.

9/24 Drlg. 2020'.

10/2 Lost circulation @ 2970'.

10/8 Sil. & 7" @ 3286'.

T.D. 3287'. WOC.

10/15 T.D. 3288'. 1400' oil.

1500 acid.

10/20 10" @ 298'.

7" @ 3286'.

Sil. 3286'.

T.D. 3288'.

1500 acid.

Pump 201.6 bbls. 4 hrs and

201.6 bbls. 4 hours.

Potential 1209 bbls.

COMPLETED

Section 19 Township 15 Range 13-WWell No. 1 - S. BoomhowerCompany Transwestern et al