

Map No. \_\_\_\_\_ Sec. 19 Twp. 15 R. 13W

Well No. 7 Sellens

C R A Company

Contractor

NE SW SE

**FIRST REPORT**  
SECTION PLAT


\_\_\_\_\_ Ft. from N. Line

990 Ft. from S. Line

\_\_\_\_\_ Ft. from E. Line

990 Ft. from W. Line

Russell County

Location \_\_\_\_\_

**RECORD**

Cased \_\_\_\_\_ in., \_\_\_\_\_ ft.

Sand \_\_\_\_\_

Gas \_\_\_\_\_

Oil \_\_\_\_\_

Total Depth \_\_\_\_\_

**PRODUCTION**

1st 24 hrs. Nat. \_\_\_\_\_

1st 24 hrs. after shot \_\_\_\_\_

Gas \_\_\_\_\_ Cu. Ft.

Dry Hole \_\_\_\_\_

Abandoned \_\_\_\_\_

Date

MAY 18 1949

19

S. J. LEWIS

Scout

Map No. K 73 Sec. 19 Twp. 15 R. 13W

Well No. 7 Sellens

C R A Company

**COMPLETE**

Contractor

NE SW SE

**E 1/732**  
SECTION PLAT


\_\_\_\_\_ Ft. from N. Line

990 Ft. from S. Line

\_\_\_\_\_ Ft. from E. Line

990 Ft. from W. Line

Russell County

Location \_\_\_\_\_

**RECORD**

Cased \_\_\_\_\_ in., \_\_\_\_\_ ft.

Sand \_\_\_\_\_

Gas \_\_\_\_\_

Oil \_\_\_\_\_

Total Depth 9267

**PRODUCTION**

1st 24 hrs. Nat. \_\_\_\_\_

1st 24 hrs. after shot \_\_\_\_\_

Gas \_\_\_\_\_ Cu. Ft.

Dry Hole \_\_\_\_\_

Abandoned \_\_\_\_\_

Date

JUN 22 1949

19

S. J. LEWIS

Scout

KANSAS

Russell

Sec. 19 Twp. 15 R. 13W ✓

Well No. #7 Sellens Farm \_\_\_\_\_  
C R A Company \_\_\_\_\_

Trapp Pool


\_\_\_\_\_ Ft. from N. Line

990' Ft. from S. Line

\_\_\_\_\_ Ft. from E. Line

990' Ft. from W. Line

NE SW SE

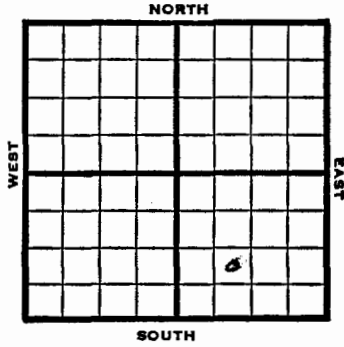

1949 Elev, 1822' REPORT

- 5/18 Drlg. 630'
  - 5/ 25 8" @ 810'  
Drlg 3045'
  - 6/1 Lans 3004'  
Arb. 3262-67'  
TD 3267'  
5" @ 3264'
  - 6/7 Swb 12½ bbls fluid PH - 70% W
  - 6/15 "
  - 6/22 Arb 3262'  
5" @ 3264'  
Pump 68 oil & 59% W Pot.  
Gr. 40.9°  
TD 3267'
- COMPLETED**

KANSAS

Russell

Section 19 Township 15 Range 13W

Well No. 7 Sellens

Company C R A

Trapp

