

Russell County Kansas State
 Map No. Sec. 19 Twp. 15 R. 13W
 Well No. 8 W. Sellens

C R A Company

C R A Contractor

NE SE SE

FIRST REPORT SECTION PLAT

Ft. from N. Line

990 Ft. from S. Line

330 Ft. from E. Line

Ft. from W. Line

Trapp Pool

Remarks:

R U R

Date JUN 8 1949 Scout S. J. LEWIS

Trapp Pool

Kansas

Map No. K 73 Sec. 19 Twp. 15 R. 13W

Well No. 8 W. Sellens

C R A

Company

COMPLETE

Contractor

NE SE SE

SECTION PLAT

Ft. from N. Line

990 Ft. from S. Line

330 Ft. from E. Line

Ft. from W. Line

Russell County

Location

Rig up

Drilling and Remarks:

Lane 2991

Cur 3254

5403255

Prof Luns.

30000000

Pump 770000 + 207000

Pot 4234

RECORD

Cased in, ft.

Sand

Gas

Oil

Total Depth 3226

PRODUCTION

1st 24 hrs. Nat.

1st 24 hrs. after shot

Gas Cu. Ft.

Dry Hole

Abandoned

Date

JUL 13 1949

19

S. J. LEWIS Scout

KANSAS Russell

Sec. 19 Twp. 15 R. 13W ✓

Well No. #8 W. Sellens Farm

C R A

Trapp Pool (C R A, Cont.) Company


Ft. from N. Line

990' Ft. from S. Line

330' Ft. from E. Line

Ft. from W. Line

NE SE SE

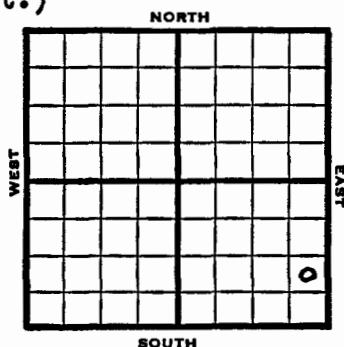

1949 Elev 1811' REPORT

6/8 RUR
6/15 8" @ 794'
Drlg 2494'
6/21 Lansing 2991'
Arb. 3254'-57'
T^u 3257'
5" @ 3255'
6/28 TD 3276' Wtr.
7/6 "
7/13 TD 3276'
Lans 2991'
Arb. 3254'
5" @ 3255'
Perf Lans 3000 acid
Pump 79 Oil / 20% W Pot
40" Gr.
Comp

COMPLETED

KANSAS

Russell

Section 19 Township 15 Range 13W

Well No. 8 W. Sellens

Company C R A

Trapp

