FORM 275 FOR SALE BY KANSAS BLUE PRINT CO.


County **Russell** State **Kansas**

Sec. **20** (Blk. Twp.) **15** (Sur. Rge.) **13W** Map No.

Operator **Helmerich & Payne**

Well No. **7** Farm **Hill**

Elev. **1860** Location **SW NE NE**

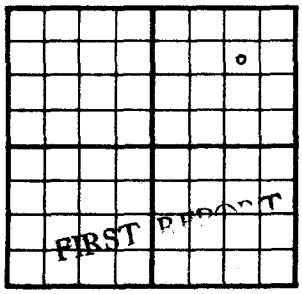

990 Ft. From **N** Line **NE**

990 Ft. From **E** Line Quarter

1st. Report OCT 22 1952

Completion

Remarks

Spudding Date

Drlg. Data

Location

J. G. McC[illegible]

FORM 275 FOR SALE BY KANSAS BLUE PRINT CO.


County Russell State Kansas

Sec. 20 (Blk. Twp.) 15 (Sur. Rge.) 13W Map No.

Operator Helmerich & Payne

Well No. 7 Farm Hill

Elev. 1860 Location SW NE NE

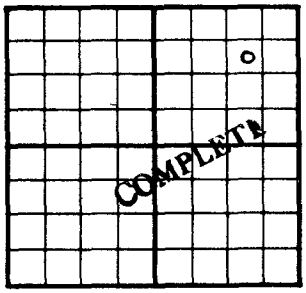

990 Ft. From N Line NE

990 Ft. From E Line Quarter

1st. Report

Completion DEC 10 1952

Remarks

Spudding Date 10-25-52

Drlg. Data Oil well TD 3227

10" @ 275 Anhy 835 Tarkio 2421

Tarkio lime 2490 Top. 2759 Heeb. 2995

Tor. 3013 Lans. 3064 TD 3227

5" @ 3208 59/ 3196-3206 64/ 3164-80

500 A 90 bsw PB 3135 118/ 3096-3116

2000 A S/ 7 boph Comp. 70 bopd

J. G. McC[illegible]

FORM 252-B
10M 8-51 TPCO.

Russell KANSAS ✓

Sec. 20 Twp. 15 R. 13W

Well No. #7 Hill Farm

Helmerich & Payne Company

Contractor


990 Ft. from N. Line

Ft. from S. Line

990 Ft. from E. Line

Ft. from W. Line

NE ¼ SW NE NE

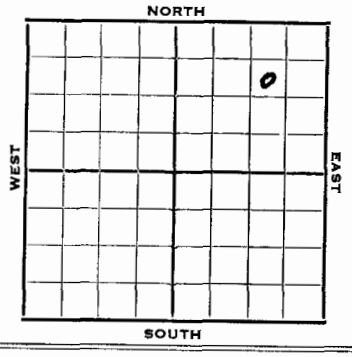

1952	Elev. 1860' REPORT
10/22	Location
10/29	10" @ 275 Anhy 835' Drlg. 2045'
11/5	Tarkio 2421 Tarkio Li 2490 Topeka 2759 Heeb. 2995 Tor. 3013 Lans. 3064 RTD 3227 5" @ 3208'
11/12	NR
11/20	"
11/27	"
12/4	"
12/10	Spud 10-25-52 Oil well TD 3227' 10" @ 275 Anhy 835' Tarkio 2421' Tarkio lime 2490' Top. 2759' Heeb 2995' Tor. 3013' Lans. 3064' TD 3227' 5" @ 3208 59/3196-3206 64/3164-80 500 A 90 BSW PB 3135 118/3096-3116 2000 A S/7 BOPH Comp. 70 BOPD COMPLETED

FORM 51 25M 3-49 PETROL Russell KANSAS

Section 20 Township 15 Range 13W

Well No. #7 Hill

Company Helmerich & Payne

