

Russell KANSAS

Russell KANSAS

SEC. 20 TWP. 15 R. 13W

DX 78-1

WELL NO. 8 Hi 11 FARM

Section 20 Township 15 Range 13W

COMPANY Helmerich & Payne


Well No. 8 Hill

CONTRACTOR Buick

Company Helmerich & Payne

Trapp Pool

990 Ft. from N. Line

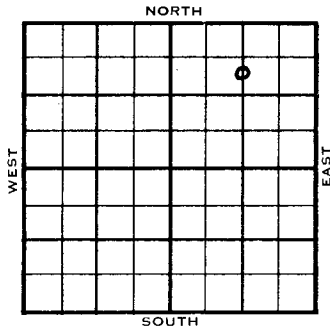


Ft. from S. Line

1320 Ft. from E. Line

Ft. from W. Line

C S 1/2 N 1/2 NE

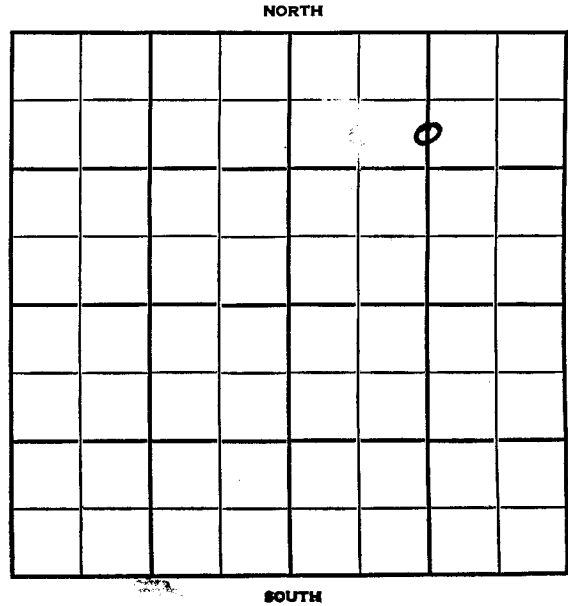

1954 ELEVATION 1870' REPORT

8/4 Location Tarkio test
 8/25 Spud 8-7-54 - Oil Well
 TD 2448'
 8" @ 166'
 Tarkio 2443'
 TD 2446'
 5" @ 2444'
 DD 2448'
 S/12 go 3 gwph 8 hrs.
 Sd-oil-frac S/13 bo 3 bw
 Comp. 25 bopd

COMPLETED