


KANSAS Kansas Pool Name Trapp
 Map No. 73 Sec. 20 Twp. 15 R. 13W
 Well No. 1 Hill

Helmerick & Payne Company

FIRST REPORT Contractor

C W L SE NE

SECTION PLAT

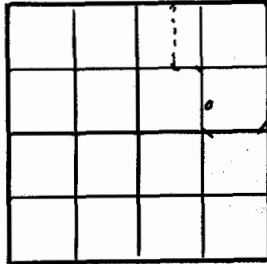

 Ft. from N. Line

660 Ft. from S. Line

990 Ft. from E. Line

 Ft. from W. Line

Russell County

Location

Rig up

Drilling and Remarks:

any 850

Lans 3082
3225

RECORD

Cased in. ft.

Sand

Gas

Oil

Total Depth

PRODUCTION

1st 24 hrs. Nat.

1st 24 hrs. after shot

Gas Cu. Ft.

Dry Hole

Abandoned

Date

MAR 27 1946

19

S. J. LEWIS

Scout


KANSAS Kansas Pool Name Trapp
 Map No. 73 Sec. 20 Twp. 15 R. 13W
 Well No. 1 Hill

Helmerick & Payne Company

COMPLETED Contractor

C W L SE NE

SECTION PLAT

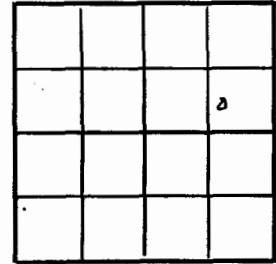

 Ft. from N. Line

660 Ft. from S. Line

990 Ft. from E. Line

 Ft. from W. Line

Russell County

Location

Rig up

Drilling and Remarks:

Lans 3082

Q 13336

5" @ 3336

Prof. Lans

5000 acid

Prod 123 Bbl

39.2 cu

RECORD

Cased in. ft.

Sand

Gas

Oil

Total Depth 3333 1/2

PRODUCTION

1st 24 hrs. Nat.

1st 24 hrs. after shot

Gas Cu. Ft.

Dry Hole

Abandoned

Date

JUN 19 1946

19

S. J. LEWIS

Scout

KANSAS Russell County

Sec. 20 Twp. 15 R. 13WWell No. #1 Hill FarmHelmerick & Payne Company


Trapp

Ft. from N. Line

660 Ft. from S. Line990 Ft. from E. Line

Ft. from W. Line

CLW SE NE

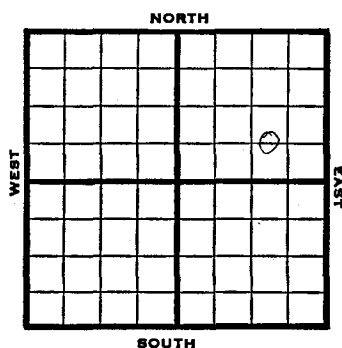

1946 Elev 1877' REPORT

3/27 Anhy 850
Lans. 3082
3225'

4/4 Arb. 3326-3337
TD 3337
5" @ 3336 RUST

4/10 Plug 3140
6 shots 3106-08
500 acid
swb 6 oil PH

4/16 Swab 80 oil in 8 hrs

4/23 800 acid
swb 88 oil in 4 hrs

5/1 Pump 109 fluid 12 hrs
40% wtr

5/7 " " "

5/14 " " "

5/21 " " "

5/29 " " "

6/5 " " "

6/19 Lans 3082'
Arb 3336
5" @ 3336'
Perf Lans
5000 acid
Pump 173 Pot.
39.0 Gr
TD 3343½'

COMPLETED

KANSAS

Russell county

Section 20 Township 15 Range 13WWell No. #1 HillCompany Helmerich & Payne