

Map No. 73 Sec. 20 Twp. 15 R. 13WWell No. 1 Hill

E. K. Carey et al. Company

FIRST REPORT Contractor

C WL NW NE


660 Ft. from N. Line

Ft. from S. Line

Ft. from E. Line

330 Ft. from W. Line

SECTION PLAT

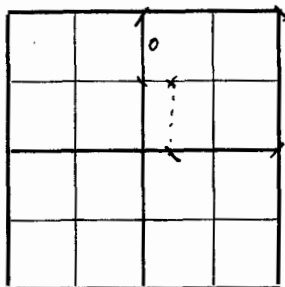

TRAPP POOL

Location

Rig up

Drilling and Remarks:

Derrick

RECORD

Cased in, ft.

Sand

Gas

Oil

Total Depth

PRODUCTION

1st 24 hrs. Nat.

1st 24 hrs. after shot

Gas Cu. Ft.

Dry Hole

Abandoned

Date

DEC 10 1941 19 S. J. LEWIS Scout

Map No. 73 Sec. 20 Twp. 15 R. 13WWell No. 1 Hill

E. K. Carey et al. Company

COMPLETED Contractor

C WL NW NE


660 Ft. from N. Line

Ft. from S. Line

Ft. from E. Line

330 Ft. from W. Line

SECTION PLAT

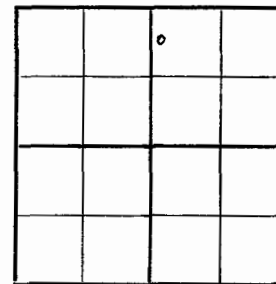

TRAPP POOL

Location

Rig up

Drilling and Remarks:

*Art 3340**5' 03350**5000 acd**Pump 804 P.D.**29° E*

RECORD

Cased in, ft.

Sand

Gas

Oil

Total Depth *3350*

PRODUCTION

1st 24 hrs. Nat.

1st 24 hrs. after shot

Gas Cu. Ft.

Dry Hole

Abandoned

Date

FEB 18 1942 19 S. J. LEWIS Scout

KANSAS

Russell

Sec. 20 Twp. 15 R. 13-W

Well No. #1 Hill Farm


E. K. Carey et al. Company
(Trapp)

660 Ft. from N. Line

Ft. from S. Line

Ft. from E. Line

330 Ft. from W. Line

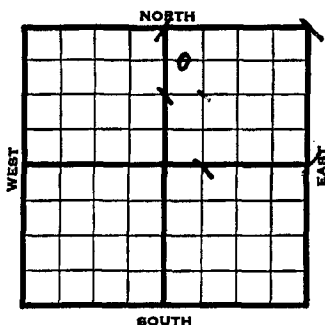

Elv. 1859

1942
2/18

Arb. 3340'
5" - 3350'
T.D. 3350'
5000 acid.
Potential 304 bbls., pump.
39. Gravity

COMPLETED

1941	REPORT
12/10	Derrick
12/18	"
12/24	8" - 515' Anhy 842'
	Drlg. 1900'
12/31	Drlg. 2340'
1942	
1/8	Lans. 3066' SO 3097-3105, 3108-13, 3164-76, 3218-22'
	Arb. 3340-50' T.D. 5" - 3350'
	RUST.
1/15	"
1/22	"
1/29	Pump 304 bbls. oil.
2/5	" " "
2/12	" " "
	OVER

KANSAS
Russell

Section 20 Township 15 Range 13-W

Well No. #1 Hill

Company E. K. Carey et al..
(Trapp)

