

KANSAS Pool Name Trapp
 Map No. 73 Sec. 20 Twp. 15 R. 13W

Well No. 5 Sylvia
Helmerich & Payne Company
FIRST REPORT Contractor

C W L SE NE

SECTION PLAT

 Ft. from N. Line
660 Ft. from S. Line
990 Ft. from E. Line
 Ft. from W. Line

Russell County

Location

Rig up

Drilling and Remarks:

10" @ 240 WOC

RECORD

Cased in., ft.
 Sand
 Gas
 Oil
 Total Depth

PRODUCTION

1st 24 hrs. Nat.
 1st 24 hrs. after shot
 Gas Cu. Ft.
 Dry Hole
 Abandoned

Date

SEP 12 1945

19

S. J. LEWIS Scout

KANSAS Pool Name Trapp
 Map No. 73 Sec. 20 Twp. 15 R. 13W

Well No. 5 Sylvia
Helmerich & Payne Company
CORRECTION Contractor

C W L SE NW

SECTION PLAT

 Ft. from N. Line
660 Ft. from S. Line
990 Ft. from E. Line
 Ft. from W. Line

Russell County

Location

Rig up

Drilling and Remarks:

reported
C W L SE NE

RECORD

Cased in., ft.
 Sand
 Gas
 Oil
 Total Depth

PRODUCTION

1st 24 hrs. Nat.
 1st 24 hrs. after shot
 Gas Cu. Ft.
 Dry Hole
 Abandoned

Date

SEP 19 1945

19

S. J. LEWIS Scout

KANSAS Russell


Pool Name Trapp Pool
 Map No. 73 Sec. 20 Twp. 15 R. 13W
 Well No. 5 Sylvia

Helmerich & Payne Company

COMPLETED

Contractor

C W L SE NW

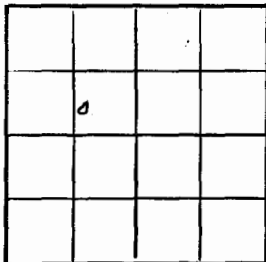E.A. 1781
SECTION PLAT

Ft. from N. Line

660 Ft. from S. Line

990 Ft. from E. Line

Ft. from W. Line

Russell County

Location

Rig up

Drilling and Remarks:

Lans 2997

7" @ 2997

PB 3042

4000 acid

Pump 275 oil + 20% Wtr.

Pot 40.9

RECORD

Cased in, ft.

Sand

Gas

Oil

Total Depth 3025

PRODUCTION

1st 24 hrs. Nat.

1st 24 hrs. after shot

Gas Cu. Ft.

Dry Hole

Abandoned

Date

OCT 31 1945 19

S. J. LEWIS Scout


Sec. 20 Twp. 15 R. 13-WWell No. #5 Sylvia FarmHelmerich & Payne Company

Ft. from N. Line

660 Ft. from S. Line

990 Ft. from E. Line

Ft. from W. Line

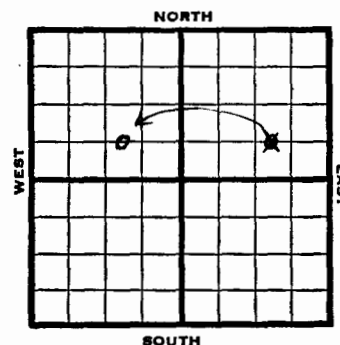

C W L SE NW

1945

Elev. 1781

REPORT

9/12

10" @ 240' WOC

9/19

Drlg. 2765

9/26

7" @ 2997

2998 RUST

10/3

Lans 2997

TD 3075

PB 3042

10/10

4000 acid. Swb. 17 oil per hr.

10/17

" " " " "

10/24

" " " " "

10/31

Lans 2997

7" @ 2997

PB 3042

4000 acid.

TD 3075'

Pump 275 oil plus 20% Wtr. Pot.

Grav. 40.9

COMPLETED

KANSAS Russell

FORM 51 5M PETROL

Section 20 Township 15 Range 13W

Well No. 5 Sylvia

Company Helmerich & Payne

