

Map No. \_\_\_\_\_ Sec. 20 Twp. 15 R. 13W

Well No. 8 Sylvia

Helmerich & Payne Company

FIRST REPORT

Contractor

C N L SE NW


SECTION PLAT

\_\_\_\_\_ Ft. from N. Line

990 Ft. from S. Line

660 Ft. from E. Line

\_\_\_\_\_ Ft. from W. Line

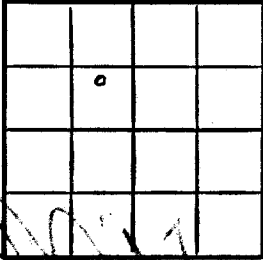

Russell County

Location \_\_\_\_\_

RECORD

Cased \_\_\_\_\_ in. \_\_\_\_\_ ft.

Sand \_\_\_\_\_

Gas \_\_\_\_\_

Oil \_\_\_\_\_

Total Depth \_\_\_\_\_

PRODUCTION

1st 24 hrs. Nat. \_\_\_\_\_

1st 24 hrs. after shot \_\_\_\_\_

Gas \_\_\_\_\_ Cu. Ft.

Dry Hole \_\_\_\_\_

Abandoned \_\_\_\_\_

Drilling and Remarks:  
10" @ 400  
any 820  
drlg. 2106  
SWD

Date

SEP 10 1947 19 S. J. LEWIS Scout

Map No. 73 Sec. 20 Twp. 15 R. 13W

Well No. 8 Sylvia

Helmerich & Payne Company

ABANDONED

Contractor

C N L SE NW


SECTION PLAT

\_\_\_\_\_ Ft. from N. Line

990 Ft. from S. Line

660 Ft. from E. Line

\_\_\_\_\_ Ft. from W. Line

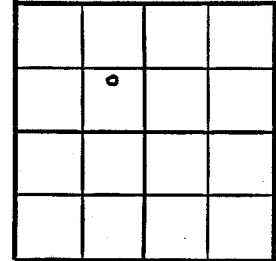

Russell County

Location \_\_\_\_\_

RECORD

Cased \_\_\_\_\_ in. \_\_\_\_\_ ft.

Sand \_\_\_\_\_

Gas \_\_\_\_\_

Oil \_\_\_\_\_

Total Depth 2578

PRODUCTION

1st 24 hrs. Nat. \_\_\_\_\_

1st 24 hrs. after shot \_\_\_\_\_

Gas \_\_\_\_\_ Cu. Ft.

Dry Hole \_\_\_\_\_

Abandoned \_\_\_\_\_

Drilling and Remarks:  
Cased 3245  
Reagan 3463  
SWD

Date

OCT 1 1947 19 S. J. LEWIS Scout

**KANSAS**

**Russell**

Sec. 20 Twp. 15 R. 13W

Well No. #8 Sylvia Farm \_\_\_\_\_

Helmerich & Payne Company


Trapp  
Ft. from N. Line

990  
Ft. from S. Line

660  
Ft. from E. Line

Ft. from W. Line

C N L SE NW

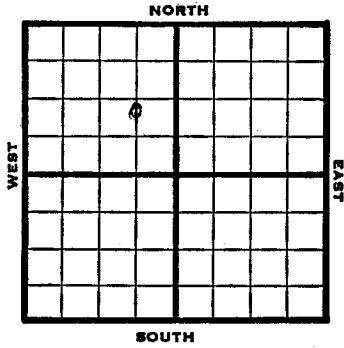

1947 Elev. 1783 REPORT

9/10 10" @ 400  
anhy 826  
Drlg. 2106  
SWD

9/17 TD 3513'  
5" @ 3325'

9/24 "

10/1 Brhuckle 3245  
Reagan 3463  
OWD  
TD 3513

**ABANDONED**

**KANSAS Russell**

Section 20 Township 15 Range 13W

Well No. 8 Sylvia

Company Helmerich & Payne

Trapp NORTH

