

Russell KANSAS

Map No. 73 Sec. 20 Twp. 15 R. 13WWell No. 1 W. W. Sellens

Gulf

Company

Contractor

FIRST REPORT

NE NW

330 Ft. from N. Line

Ft. from S. Line

330 Ft. from E. Line

Ft. from W. Line

SECTION PLAT

CORALENA SOUTH POOL

Location

Rig up

Drilling and Remarks:

Rotary

RECORD

Cased _____ in., _____ ft.

Sand

Gas

Oil

Total Depth

PRODUCTION

1st 24 hrs. Nat.

1st 24 hrs. after shot

Gas _____ Cu. Ft.

Dry Hole

Abandoned

Date

JUL 5 1939 19

S. J. LEWIS

Scout

Russell KANSAS

Map No. _____ Sec. 20 Twp. 15 R. 13WWell No. 1 W. W. Sellens

Gulf

Company

Contractor

COMPLETED

NE NW

330 Ft. from N. Line

Ft. from S. Line

330 Ft. from E. Line

Ft. from W. Line

SECTION PLAT

CORALENA SOUTH POOL

Location

Rig up

Drilling and Remarks:

*Qu & 3301**5" C 3302**Minimax**15 1/2*

RECORD

Cased _____ in., _____ ft.

Sand

Gas

Oil

Total Depth *3306 1/2*

PRODUCTION

1st 24 hrs. Nat.

1st 24 hrs. after shot

Gas _____ Cu. Ft.

Dry Hole

Abandoned

Date

AUG 9 1939 19

S. J. LEWIS

Scout

KANSAS

Russell

Sec. 20 Twp. 15 R. 13-W

Well No. #1 W. W. Sellens Farm

Gulf

Company

(South Coralena)


330 Ft. from N. Line

Ft. from S. Line

330 Ft. from E. Line

Ft. from W. Line

Elev. 1842

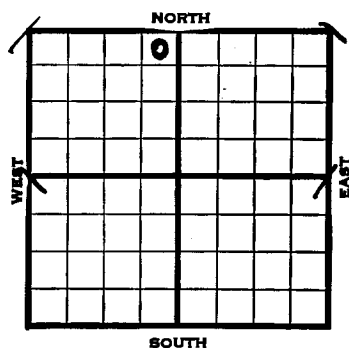

REPORT

1939	
7/5	Rotary.
7/13	9" - 103' Drlg. 2630'
7/20	Topeka 2732' Lans. 3040'
	Arb. 3301' 5" - 3302'
	T.D. 3303½' RUST.
7/27	T. D. 3306½' Small show oil.
	Shut down.
8/3	Pump 132 oil & 11 water 16 hours
8/9	Arb. 3301'
	5" - 3302'
	T.D. 3306½'
	Minimum 15 bbls.

COMPLETED

Russell

KANSAS

Form 51-5M-11-38-Palace

Section 20 Township 15 Range 13-W

Well No. #1 W. W. Sellens

Company Gulf

