

Map No. 73 Sec. 20 Twp. 15 R. 13WWell No. 6 Geo. Sellens

Coralena

Company

Contractor

FIRST REPORT
C W L NW SE660 Ft. from N. Line

Ft. from S. Line

Ft. from E. Line

330 Ft. from W. Line

SECTION PLAT

		o	

CORALENA POOL

Location X

RECORD

Cased _____ in., _____ ft.

Sand _____

Gas _____

Oil _____

Total Depth _____

PRODUCTION

1st 24 hrs. Nat. _____

1st 24 hrs. after shot _____

Gas _____ Cu. Ft.

Dry Hole _____

Abandoned _____

Date

OCT 18 1939 19 S. J. LEWIS ScoutMap No. 73 Sec. 20 Twp. 15 R. 13WWell No. 6 Geo. Sellen

Coralena

Company

Contractor

COMPLETED

SECTION PLAT

660 C W L NW SE
Ft. from N. Line

Ft. from S. Line

Ft. from E. Line

330 Ft. from W. Line

		o	

CORALENA POOL

Location _____

RECORD

Cased _____ in., _____ ft.

Sand _____

Gas _____

Oil _____

Total Depth 3820

PRODUCTION

1st 24 hrs. Nat. _____

1st 24 hrs. after shot _____

Gas _____ Cu. Ft.

Dry Hole _____

Abandoned _____

Date

NOV 22 1939 19 S. J. LEWIS Scout

FORM 252-A 5M ~~KANSAS~~ - Russell

Sec. 20 Twp. 15 R. 13-W

Well No. #6 Geo. Sellens Farm

Coralena

Company

(Coralena)


660 Ft. from N. Line

_Ft. from S. Line

Ft. from E. Line

330 Ft. from W. Line

Elev. 1875

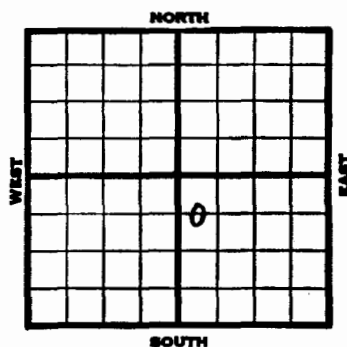

1939	REPORT
10/18	Location
10/26	Rotary.
11/2	Drlg. 660'
11/9	10" - 256' Anhy 850'
	Drlg. 2565'
11/16	Lans. 3015' Arb. 3315'
	7" - 3316' T.D. RUST.
11/22	Arb. 3315'
	7" - 3316'
	T.D. 3320'
	Echometer potential 1772 bbls.
	COMPLETED

KANSAS

Form 51-5M-7-39-Palace

Russell

Section 20 Township 15 Range 13-W

Well No. #6 Geo. Sellens

Company Coralena

NORTH Coralena Pool

