

Russell KANSAS

SEC. 20	TWP. 15	R. 13W
---------	---------	--------

WELL NO. #6 Sellens FARM

COMPANY Julian Oil & Royalty

CONTRACTOR Julian Oil & Royalty

Trapp Pool

495 Ft. from N. Line

_____ Ft. from S. Line

_____ Ft. from E. Line

1155 Ft. from W. Line

SE NE NW SW


Russell KANSAS

FORM 51

Section 20 Township 15 Range 13W

Well No. #6 Sellens

Company Julian Oil & Royalty

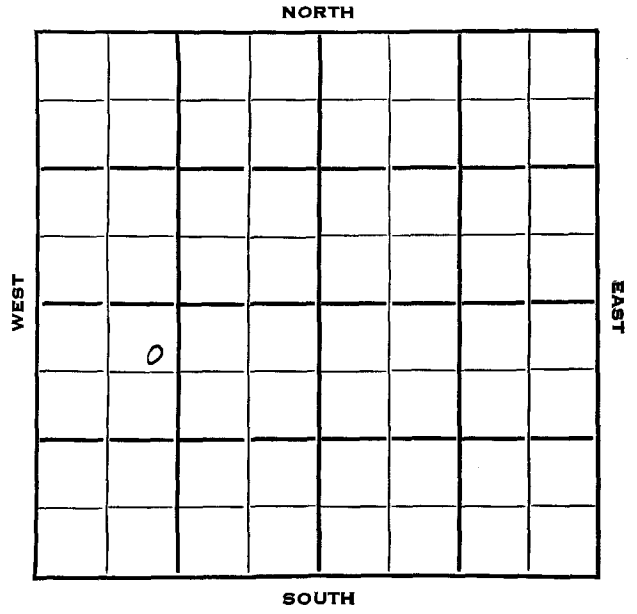

ELEVATION	REPORT
<u>1954</u>	1788'
3/2	Spud 2-28-54 Drlg 155'
3/10	Anhy 760' 10" @ 766 Drlg. 770'
3/17	Drlg. 1760'
3/24	8" @ 2027 Drlg. 2355'
3/31	Drlg. 2525'
4/7	Top 2670' Dodge 2910 Lans 2966 Drlg. 3100'
5/5	Spud 2-28-54 Oil Well TD 3235' Anhy 760', 10" @ 766' 8" @ 2027' Arb 3232' 5" @ 3232' TD 3235' FU 1000' oil Tarkio 2350' S/ 3 boph 30 gw. Comp 35 bopd.

COMPLETED

DX-78