

Russell KANSAS

SEC.	TWP.	R.
20	15	13W ✓

WELL NO. _____
 COMPANY #5 Sellens FARM

CONTRACTOR Julian Oil & Royalty

Julian


Trapp Pool
 _____ Ft. from N. Line

1485 _____ Ft. from S. Line

_____ Ft. from E. Line

990 _____ Ft. from W. Line

SE NW SW

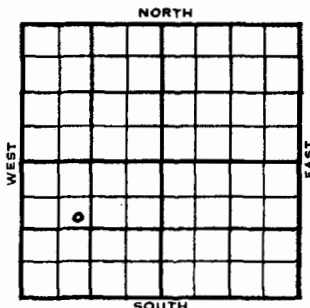

1954

Information brought forward.

3/3

10" @ 775'
 Tarkio 2340'
 B/ 60 goph 1 hr.
 8" @ 2470'
 Top 2670', Lans 2968', Arb 3242',
 TD 3243'
 FU 900' oil 30 min
 5" @ 3243'
 DD 3250'
 FU 2100' oil 5 hr.
 Comp 150 bopd.

COMPLETED

1953	ELEVATION	REPORT
	1795'	
11/30	RUCT	
12/9	Drlg. 350'	
12/16	15" @ 350'	
1954		
1/6	Drlg. 1750'	
1/13	Tarkio 2340' B/60 goph 1 hrs., Drlg. 2355'	
1/20	8" @ 2470' Drlg. 2520'	
1/27	Drlg. 2965'	
2/3	Top 2670', Lans 2968'	
2/10	Arb. 3242' TD 3243' 900' oil 30 mins 5" @ 3243'	
2/17	DD 3250' TD	
2/24	NR	
3/3	Spud 12-2-53 Oil Well TD 3250' 15" @ 350' Anhy 765'	

OVER

FORM 51

Russell KANSAS

Section 20 Township 15 Range 13 W

Well No. # 5 Sellens

Company Julian Oil & Royalty

