

Map No. 73 Sec. 20 Twp. 15 R. 13W

Well No. 1 G. Sellers

Southern Oil Company

Contractor

SECTION PLAT

_____ Ft. from N. Line

330 Ft. from S. Line

_____ Ft. from E. Line

990 Ft. from W. Line

FIRST REPORT

Location _____

Rig up _____

Drilling and Remarks:

Rig

RECORD

Cased _____ in., _____ ft.

Sand _____

Gas _____

Oil _____

Total Depth _____

PRODUCTION

1st 24 hrs. Nat. _____

1st 24 hrs. after shot _____

Gas _____ Cu. Ft.

Dry Hole _____

Abandoned _____

Date

OCT 21 1936 19

S. J. LEWIS Scout

Map No. 73 Sec. 20 Twp. 15 R. 13W

Well No. 1 C. Sellers

Southern Oil Company

Contractor

SECTION PLAT

_____ Ft. from N. Line

380 Ft. from S. Line

_____ Ft. from E. Line

990 Ft. from W. Line

COMPLETED

Location _____

Rig up _____

Drilling and Remarks:

*Running 2988
4000 acid
P & 1063 oil
plus 5% water*

RECORD

Cased _____ in., _____ ft.

Sand _____

Gas _____

Oil _____

Total Depth 3004

PRODUCTION

1st 24 hrs. Nat. _____

1st 24 hrs. after shot _____

Gas _____ Cu. Ft.

Dry Hole _____

Abandoned _____

Date

DEC 9 1936 19

S. J. LEWIS Scout

Sec. 20 Twp. 15 R. 13W

Well No. #1 G. Sellens Farm

Sothorn Oil Co. Company


Ft. from N. Line

330' Ft. from S. Line

Ft. from E. Line

990' Ft. from W. Line

Elev. 1801

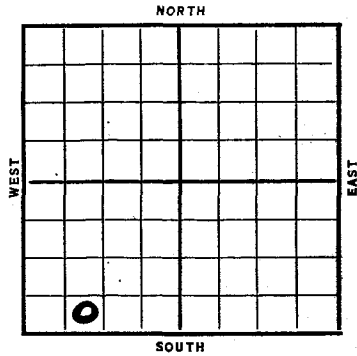

REPORT

Date	REPORT
1936	
10/21	Rig.
10/29	Rigging up.
11/6	10" @ 235 Drlg. 890
11/12	Drlg. 1940
11/19	Lansing 2988'. 7" @ 2992'. Rust
11/27	---
12/3	T. D. 3004'. 4000 acid. No test.
12/9	Lansing 2988 4000 acid Pot. 1063 oil plus 5% water T.D. 3004

COMPLETED

Section 20 Township 15 Range 13-W

Well Number #1 G. Sellens

Company Southern Oil

