


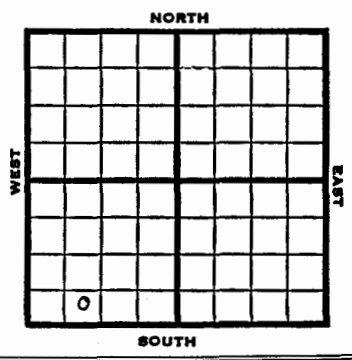

FORM 252-B  
10M 11-50 PETROL **Russell** **KANSAS**  
Sec. 20 Twp. 15 R. 13 W ✓

Well No. # 1 Sellers Farm  
Jones, Shelburne & Farmer, Inc. Company  
Contractor

**Trapp Pool**  
Ft. from N. Line  
450 Ft. from S. Line  
Ft. from E. Line  
990 Ft. from W. Line  
**SE SW SW (Twin well)**



1951	Elev. 1800'	REPORT
7/11	Drlg. 1000'	
9/12	Spud 7-12-51	
	Oil well TD 3239'	13" @ 770
	10" @ 2078	8" @ 2490'
	1" or. 2973'	KC 2983' Arb. 3235'
	TD 3239'	5" @ 3235' FU 15 BO
	2 hr.	
	Comp. 80 BOPD	
<b>COMPLETED</b>		

FORM 51 25M 8-50 WESTERN **Russell** **KANSAS**  
Section 20 Township 15 Range 13 W  
Well No. # 1 Sellers  
Company Jones, Shelburne & Farmer, Inc.

