

Kansas

Map No. \_\_\_\_\_ Sec. 20 Twp. 15 R. 13W

Well No. 1 Sellens

Jones, Shelborne & Farmer Company

Contractor

NE SW SW

SECTION PLAT


FIRST REPORT

Ft. from N. Line

990 Ft. from S. Line

Ft. from E. Line

990 Ft. from W. Line

Russell County

Location \_\_\_\_\_

Rig up \_\_\_\_\_

Drilling and Remarks:

Spud 4-20-50

drlg. 420

RECORD

Cased \_\_\_\_\_ in., \_\_\_\_\_ ft.

Sand \_\_\_\_\_

Gas \_\_\_\_\_

Oil \_\_\_\_\_

Total Depth \_\_\_\_\_

PRODUCTION

1st 24 hrs. Nat. \_\_\_\_\_

1st 24 hrs. after shot \_\_\_\_\_

Gas \_\_\_\_\_ Cu. Ft.

Dry Hole \_\_\_\_\_

Abandoned \_\_\_\_\_

Date

APR 26 1950 19

J. E. TYRA

Scout

Kansas

Map No. \_\_\_\_\_ Sec. 20 Twp. 15 R. 13W

Well No. 1 Sellens

Jones-Shelborne & Farmer Company

Contractor

NE SW SW

SECTION PLAT


COMPLETE

Ft. from N. Line

990 Ft. from S. Line

Ft. from E. Line

990 Ft. from W. Line

Russell County

Location \_\_\_\_\_

Rig up \_\_\_\_\_

Drilling and Remarks:

13" @ 435

10" @ 766

Anhy 772

8" @ 2510

Topeka 2690

Lans. 2986

1 boph 2990-3005

7" @ 3085

Date

JUL 5 1950 19

J. E. TYRA

Scout

RECORD

Cased \_\_\_\_\_ in., \_\_\_\_\_ ft.

Sand \_\_\_\_\_

Gas \_\_\_\_\_

Oil \_\_\_\_\_

Total Depth 3260

PRODUCTION

1st 24 hrs. Nat. \_\_\_\_\_

1st 24 hrs. after shot \_\_\_\_\_

Gas \_\_\_\_\_ Cu. Ft.

Dry Hole \_\_\_\_\_

Abandoned \_\_\_\_\_

Russell KANSAS  
15 R. 13W ✓

Sec. 20 Twp. \_\_\_\_\_

Well No. #1 Sellens Farm

Jones, Shelborne & Farmer Company

Contractor


Ft. from N. Line

990' Ft. from S. Line

Ft. from E. Line

990' Ft. from W. Line

NE SW SW

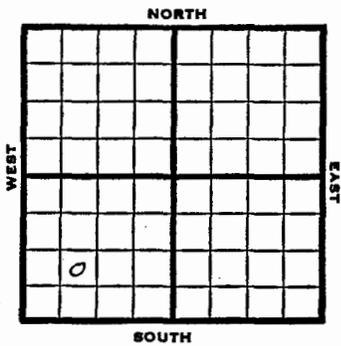


Russell KANSAS

Section 20 Township 15 Range 13W

Well No. #1 Sellens

Company Jones, Shelborne & Farmer

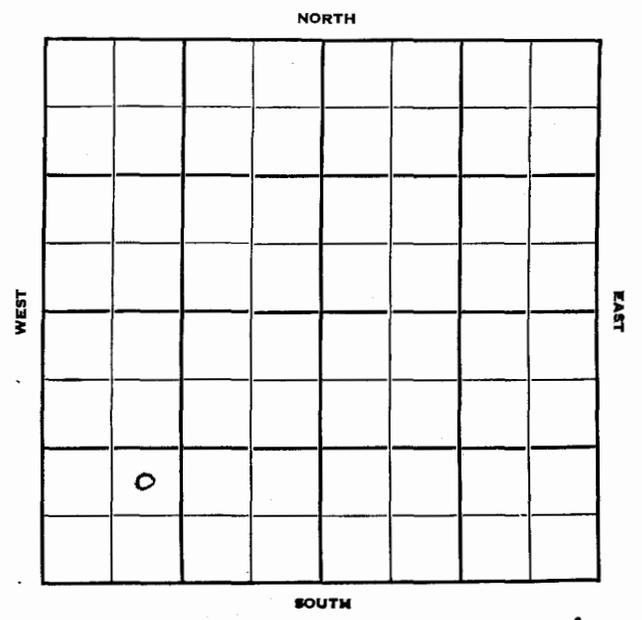

1950 Elev 1794 REPORT

4/26 Spud 4-20-50  
 Drlg. 420'  
 7/5 13" @ 435  
 10" @ 766  
 Anhy 772  
 8" @ 2510  
 Topeka 2690 Lans 2986  
 1 boph 2990-3005  
 7" @ 3085  
 FU 400' oil & hr  
 Arb 3248  
 TD 3260  
 FU 2000' oil  
 Comp 449 bopd  
 Completed  
**COMPLETED**