

KANSAS Russell

Map No. _____ Sec. 20 Twp. 15 R. 13W
 Well No. 2 - Geo. Sellens
Coralena Company
 Contractor

FIRST REPORT SECTION PLAT

_____ Ft. from N. Line

330 Ft. from S. Line330 Ft. from E. Line

_____ Ft. from W. Line

Location _____

Rig up _____

Drilling and Remarks:

T.D. 500
Ring pipe

RECORD

Cased _____ in., _____ ft.

Sand _____

Gas _____

Oil _____

Total Depth _____

PRODUCTION

1st 24 hrs. Nat. _____

1st 24 hrs. after shot _____

Gas _____ Cu. Ft.

Dry Hole _____

Abandoned _____

Date

JUN 30 1937

19

H. D. Hatfield

Scout

KANSAS Russell

Map No. _____ Sec. 20 Twp. 15 R. 13W
 Well No. 2 - Geo. Sellens
Coralena Company
 Contractor

COMPLETED

_____ Ft. from N. Line

330 Ft. from S. Line330 Ft. from E. Line

_____ Ft. from W. Line

SECTION PLAT

Location _____

Rig up _____

Drilling and Remarks:

Pumped 1135/12
Pot - 2270

RECORD

Cased 7 in. 3305 ft.Sand Sil 3306Gas (corrected)

Oil _____

Total Depth 3309

PRODUCTION

1st 24 hrs. Nat. _____

1st 24 hrs. after shot _____

Gas _____ Cu. Ft.

Dry Hole _____

Abandoned _____

Date

JUL 28 1937

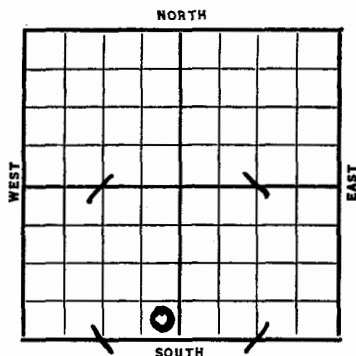
19

H. D. Hatfield

Scout

KANSAS

Russell

Sec. 20 Twp. 15 R. 13-WWell No. #2 Geo. Sellens FarmCoralena Company Ft. from N. Line330 Ft. from S. Line330 Ft. from E. Line Ft. from W. Line

Date REPORT

1937

6/30 TD 500

Running pipe

7/9 12" @ 499'. Drlg. 2061'.

7/16 Oswald 3042' & 7".

T.D. 3047'. RUST.

7/23 Sil. 3303'. T.D. 3306'.

Rng. liner.

7/28 7" @ 3305'.

Sil. 3306' (Corrected)

T.D. 3309'.

Pumped 1135 bbls. 12 hrs.

Pot. 2270 bbls.

~~COMPLETED~~ COMPLETED

KANSAS

Russell

Section 20 Township 15 Range 13-WWell Number #2 Geo. SellensCompany Coralena