

Map No. 73 Sec. 20 Twp. 15 R. 13WWell No. 1 Geo. SellensCoralena Oil & Gas Company

Contractor

SECTION PLAT

Ft. from N. Line

630 Ft. from S. Line990 Ft. from E. Line

Ft. from W. Line

FIRST REPORT

Location

Rig up

Drilling and Remarks:

Stal Rig

RECORD

Cased _____ in., _____ ft.

Sand _____

Gas _____

Oil _____

Total Depth _____

PRODUCTION

1st 24 hrs. Nat. _____

1st 24 hrs. after shot _____

Gas _____ Cu. Ft.

Dry Hole _____

Abandoned _____

Date

APR 15 1936 192 S. J. LEWIS ScoutMap No. 73 Sec. 20 Twp. 15 R. 13WWell No. 1 Geo. SellensCoralena Oil & Gas Company

Contractor

SECTION PLAT

Ft. from N. Line

330 Ft. from S. Line990 Ft. from E. Line

Ft. from W. Line

COMPLETED

Location

Rig up

Drilling and Remarks:

Running 3047
5000 acid
598 8 1/2

RECORD

Cased _____ in., _____ ft.

Sand _____

Gas _____

Oil _____

Total Depth 3064

PRODUCTION

1st 24 hrs. Nat. _____

1st 24 hrs. after shot _____

Gas _____ Cu. Ft.

Dry Hole _____

Abandoned _____

Date

JUN 24 1936 19 S. J. LEWIS Scout

RUSSELL

KANSAS

Map No. _____ Sec. 20 Twp. 15 R. 13-W

Well No. 1-Geo. Sellens Farm

Coralena O & G Company


Ft. from N. Line

330 Ft. from S. Line

990 Ft. from E. Line

Ft. from W. Line

Elev. 1858

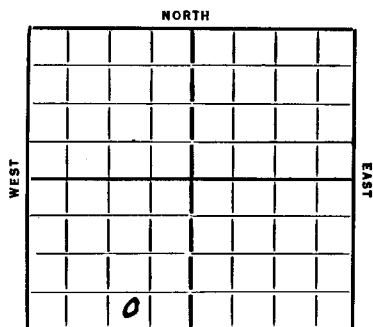

REPORT

Date
1936

4/15 Std Rig

4/23 Spud.

4/30 Drlg. 457'

5/7 Drlg. 1055'.

5/14 Drlg. 2095'.

5/21 8" @ 2135'. Drlg. 2400'.

5/28 Drlg. 2710'. 6" @ 2528'.

6/4 6" @ 2720'. Topeka 2758'. Drlg. 28x
2850'.

6/11 Lansing 3030'. T.D. 3035'. Under
ream 6".

6/24/36-Lansing 3047'.

5000 gallons acid.

T.D. 3064'.

898 bbls of oil.

COMPLETED

KANSAS

Form 51-5M-4-36-Palace

RUSSELL

Section 20 Township 15 Range 13-W

Well Number 1-Geo. Sellens

Company Coralena O & G

