

Map No. \_\_\_\_\_ Sec. 21 Twp. 15 R. 13W

Well No. 1 Redetzke

Cities Service Oil Company

Contractor

FIRST REPORT

NE/C


330 Ft. from N. Line

\_\_\_\_\_ Ft. from S. Line

330 Ft. from E. Line

\_\_\_\_\_ Ft. from W. Line

SECTION PLAT

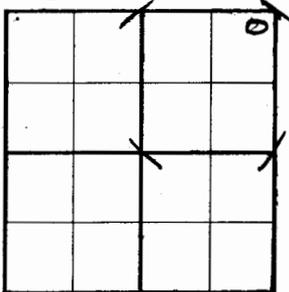

NORTH FAIRFIELD POOL

Location \_\_\_\_\_

RECORD

Cased \_\_\_\_\_ in., \_\_\_\_\_ ft.

Sand \_\_\_\_\_

Gas \_\_\_\_\_

Oil \_\_\_\_\_

Total Depth \_\_\_\_\_

PRODUCTION

1st 24 hrs. Nat. \_\_\_\_\_

1st 24 hrs. after shot \_\_\_\_\_

Gas \_\_\_\_\_ Cu. Ft.

Dry Hole \_\_\_\_\_

Abandoned \_\_\_\_\_

Rig up \_\_\_\_\_  
Drilling and Remarks:

ROG

Date

FEB 1 - 1939 19 H. D. Hatfield Scout

Map No. 73 Sec. 21 Twp. 15 R. 13W

Well No. 1 Redetzke

Cities Service Oil Company

Contractor

COMPLETED

NE/C


330 Ft. from N. Line

\_\_\_\_\_ Ft. from S. Line

330 Ft. from E. Line

\_\_\_\_\_ Ft. from W. Line

SECTION PLAT

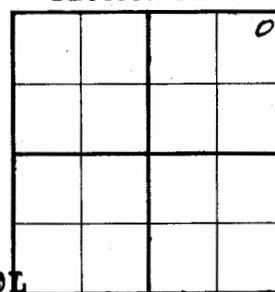

NORTH FAIRFIELD POOL

Location \_\_\_\_\_

RECORD

Cased 8 in., 3080 ft.

Sand LENS 3060

Gas \_\_\_\_\_

Oil \_\_\_\_\_

Total Depth 3093

PRODUCTION

1st 24 hrs. Nat. \_\_\_\_\_

1st 24 hrs. after shot \_\_\_\_\_

Gas \_\_\_\_\_ Cu. Ft.

Dry Hole \_\_\_\_\_

Abandoned \_\_\_\_\_

Rig up \_\_\_\_\_  
Drilling and Remarks:

10,000 Acid

P-250/8

Pot 749

Date

MAR 15 1939 19 H. D. Hatfield Scout

Sec. 21 Twp. 15 R. 13-7

Well No. #1 Redetzke Farm

Cities Service Oil Company

(North Fairfield)


330 Ft. from N. Line

\_\_\_\_\_ Ft. from S. Line

330 Ft. from E. Line

\_\_\_\_\_ Ft. from W. Line

Elev. 1882

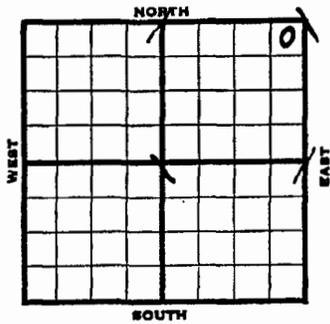

1939	REPORT	O. W. D. D
2/1	ROG.	
2/10	Dlg. 300'	
2/17	12" - 498' Drlg. 1520	
2/23	Drlg. 2600'	
3/3	Lans. 3060' S. O. 3081-86' T.D.	
	8" - 3080' RUST.	
3/10	T. D. 3093' No fill-up.	
	Will treat.	
3/15	8" - 3080'	
	Lans. 3060'	
	T. D. 3093'	
	10,000 acid.	
	Pump 250 bbls. 8 hours.	
	Potential 749 bbls.	
	<b>COMPLETED</b>	
	<b>OVER</b>	

**O. W. D. D**

1940  
6/22

Old T.D. 3093'  
Lans. 3060'

6/27

Drlg. 3247'

7/3

Arb. ~~3311~~ 16' T.D.  
Ran 7"

7/11

Arb. 3311' (Corrected)  
7" - 3314' T.D. 3322'  
2000 acid.  
Depthograph 1600 bbls.  
3000 acid  
No test.

7/18

" "

7/24

Arb. 3311'  
7" - 3314'  
T.D. 3322'  
5000 acid.  
Echometer potential 2936 bbls.

**COMPLETED**

Map No. \_\_\_\_\_ Sec. 21 Twp. 15 R. 13W

Well No. 1 Redetzke

Cities Service Oil Company

Contractor

**FIRST REPORT**

NE/C

**SECTION PLAT**


330 Ft. from N. Line

\_\_\_\_\_ Ft. from S. Line

330 Ft. from E. Line

\_\_\_\_\_ Ft. from W. Line

CORALENA POOL

Location \_\_\_\_\_

**RECORD**

Cased \_\_\_\_\_ in., \_\_\_\_\_ ft.

Sand \_\_\_\_\_

Gas \_\_\_\_\_

Oil \_\_\_\_\_

Total Depth \_\_\_\_\_

**PRODUCTION**

1st 24 hrs. Nat. \_\_\_\_\_

1st 24 hrs. after shot \_\_\_\_\_

Gas \_\_\_\_\_ Cu. Ft.

Dry Hole \_\_\_\_\_

Abandoned \_\_\_\_\_

Date  
JUN 19 1940

19

S. J. LEWIS Scout

Map No. 73 Sec. 21 Twp. 15 R. 13W

Well No. 1 Redetzke

Cities Service Oil Company

Contractor

**CORRECTION**

NE/C

**SECTION PLAT**


330 Ft. from N. Line

\_\_\_\_\_ Ft. from S. Line

330 Ft. from E. Line

\_\_\_\_\_ Ft. from W. Line

CORALENA POOL

Location \_\_\_\_\_

**RECORD**

Cased \_\_\_\_\_ in., \_\_\_\_\_ ft.

Sand \_\_\_\_\_

Gas \_\_\_\_\_

Oil \_\_\_\_\_

Total Depth \_\_\_\_\_

**PRODUCTION**

1st 24 hrs. Nat. \_\_\_\_\_

1st 24 hrs. after shot \_\_\_\_\_

Gas \_\_\_\_\_ Cu. Ft.

Dry Hole \_\_\_\_\_

Abandoned \_\_\_\_\_

Date  
JUN 22 1940

19

S. J. LEWIS Scout

Map No. \_\_\_\_\_ Sec. 21 Twp. 15 R. 13W

Well No. 1 Redetzke

Cities Service Oil Company

Contractor

COMPLETED

NE/C

330 Ft. from N. Line


\_\_\_\_\_ Ft. from S. Line

330 Ft. from E. Line

\_\_\_\_\_ Ft. from W. Line

CORALENA POOL

SECTION PLAT

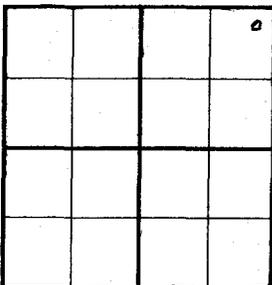

Location \_\_\_\_\_

Rig up \_\_\_\_\_

Drilling and Remarks:

*Case 3311  
7" @ 3314  
5000 acid  
Echometer 28  
2986*

RECORD

Cased \_\_\_\_\_ in., \_\_\_\_\_ ft.

Sand \_\_\_\_\_

Gas \_\_\_\_\_

Oil \_\_\_\_\_

Total Depth 3322

PRODUCTION

1st 24 hrs. Nat. \_\_\_\_\_

1st 24 hrs. after shot \_\_\_\_\_

Gas \_\_\_\_\_ Cu. Ft.

Dry Hole \_\_\_\_\_

Abandoned \_\_\_\_\_

Date

JUL 24 1940 19


S. J. LEWIS Scout

Section 21 Township 15 Range 13-W

Well No. 1 Redetzke

Company Cities Service Oil

NORTH North Fairfield Pool

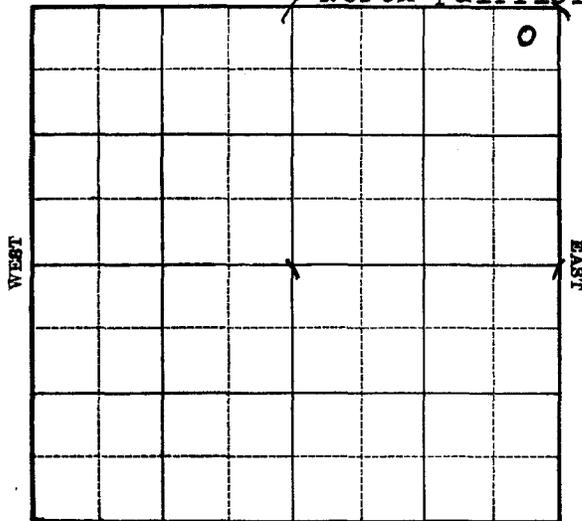

O. W. D. D