

KANSAS
Map No. 73 Sec. 21 Twp. 15 R. 13WWell No. 1 Redetzke

Alpine & Armer Company

FIRST REPORT Contractor

NE SE


SECTION PLAT

330 Ft. from N. Line

Ft. from S. Line

330 Ft. from E. Line

Ft. from W. Line

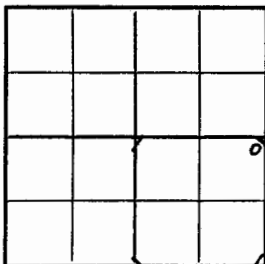

SELIENS POOL

Location

Rig up

Drilling and Remarks:

Cable

RECORD

Cased in, ft.

Sand

Gas

Oil

Total Depth

PRODUCTION

1st 24 hrs. Nat.

1st 24 hrs. after shot

Gas Cu. Ft.

Dry Hole

Abandoned

Date

MAY 26 1943 19 S. J. LEWIS Scout

KANSAS
Map No. 73 Sec. 21 Twp. 15 R. 13WWell No. 1 Redetzke

Alpine & Armer Company

ABANDONED Contractor

NE SE


SECTION PLAT

330 Ft. from N. Line

Ft. from S. Line

330 Ft. from E. Line

Ft. from W. Line

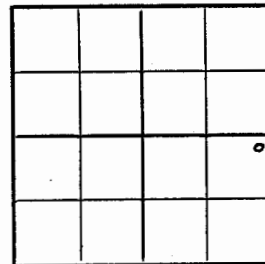

SELIENS POOL

Location

Rig up

Drilling and Remarks:

Per X 3364NFW

RECORD

Cased in, ft.

Sand

Gas

Oil

Total Depth 3387

PRODUCTION

1st 24 hrs. Nat.

1st 24 hrs. after shot

Gas Cu. Ft.

Dry Hole

Abandoned

Date

JUL 7 1943 19 S. J. LEWIS Scout

KANSAS

Russell

Sec. 21 Twp. 15 R. 13-W

Well No. #1 Redetzke Farm

Alpine & Armer Company

Sellens


330 Ft. from N. Line

 Ft. from S. Line

330 Ft. from E. Line

 Ft. from W. Line

Elev. 1967

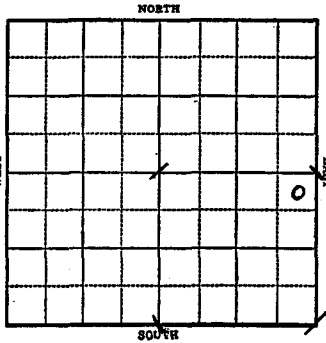

R E P O R T

1943

5/26 Cable
6/2 12" @ 425
Drlg. 820
6/9 Drlg. 1670-10" @ 840'
6/16 8" @ 2175'
Drlg. 24858'
6/23 8" @ 2548'
Drlg. 2580'
6/30 Lans 3084'
Drlg. 3150'
7/7 Arb. 3364'
T.D. 3381'
HFW

ABANDONED

KANSAS

Russell

Section 21 Township 15 Range 13-W

Well No. #1 Redetzke

Company Alpine & Armer

