

Map No. _____ Sec. 21 Twp. 15 R. 13W

Well No. 1 Meharg

D. R. Lauck _____ Company

Contractor

NW NE NW

SECTION PLAT

330 Ft. from N. Line

_____ Ft. from S. Line

990 Ft. from E. Line

_____ Ft. from W. Line

FIRST REPORT

Russell **NO RECORD**

Location _____

Rig up _____

Drilling and Remarks:

Topeka 2600

K. C. 3055

Arb. 3318

OTD 3327

5" @ 3319

To P.B. to K. C.

RECORD

Cased _____ in., _____ ft.

Sand _____

Gas _____

Oil _____

Total Depth _____

PRODUCTION

1st 24 hrs. Nat. _____

1st 24 hrs. after shot _____

Gas _____ Cu. Ft.

Dry Hole _____

Abandoned _____

Date

JUN 7 1950 19 J. E. TYRA Scout

Kansas

OWTIO

Map No. _____ Sec. 21 Twp. 15 R. 13W

Well No. 1 Meharg

D. R. Lauck _____ Company

Contractor

NW NE NW

El. 1879

SECTION PLAT

330 Ft. from N. Line

_____ Ft. from S. Line

990 Ft. from E. Line

_____ Ft. from W. Line

ABANDONED

Russell County

Location _____

Rig up _____

Drilling and Remarks:

Topeka 2600

KC 3055

Arb. 3318

OTD 3327

5" @ 3319

PB 3130

RECORD

Cased _____ in., _____ ft.

Sand _____

Gas _____

Oil _____

Total Depth 3100

PRODUCTION

1st 24 hrs. Nat. _____

1st 24 hrs. after shot _____

Gas _____ Cu. Ft.

Dry Hole _____

Abandoned _____

Date

JUN 21 1950 19 J. E. TYRA Scout

NO-RECORD KANSAS

Russell

Sec. 21 Twp. 15 R. 13-W

Well No. #1 Meharg Farm

D. R. Lauck Company

Trapp Contractor

330 Ft. from N. Line


Ft. from S. Line

990 Ft. from E. Line

Ft. from W. Line

NW NE NW

O. W. P. B.

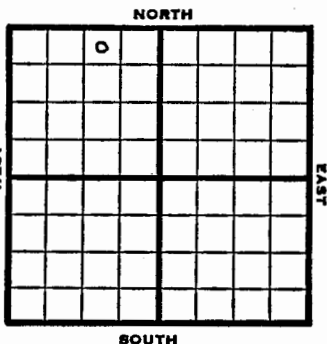

1950 Elev 1879 REPORT

6/7 Topeka 2600
K.C. 3055
Arb 3318
O.T.D. 3327
5" @ 3319
to P.B. to K.C.

6/21 TD 3100
Topeka 2600 KC 3055
Arb 3318
OTD 3327
5" @ 3319
PB 3130
43/3083-3100
1000 acid NS
D&A

ABANDONED

Russell

KANSAS

Section 21 Township 15 Range 13W

Well No. #1 Meharg

Company D. R. Lauck

