

O. W. D. D

KANSAS
15

Russell
13-W

Sec. 21 Twp. 15 R. _____

Well No. #2 Karst Farm _____

R L Williams Company _____

Harms & Knight Contractor _____

Trapp


_____ Ft. from N. Line

660 Ft. from S. Line

_____ Ft. from E. Line

990 Ft. from W. Line

C E L SW SW

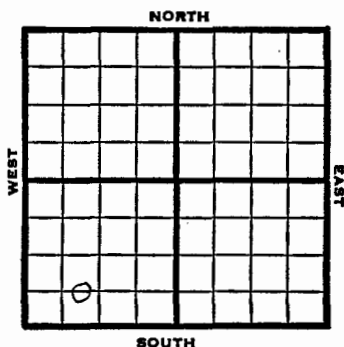

O. W. D. D


Russell

KANSAS

Section 21 Township 15 Range 13W

Well No. #2 Karst

Company R. L. Williams

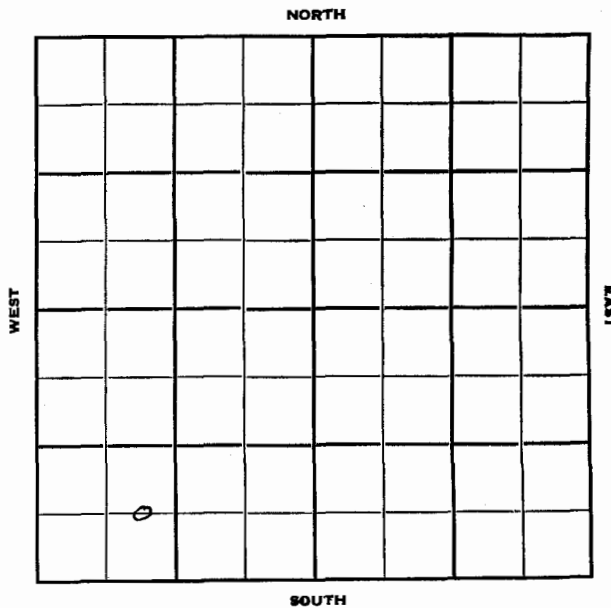

1950 Elev. 1868' REPORT

10/11 8" @ 150
Anhy 835
drlg 2015

11/29 Oil Well TD. 3101
8" @ 150 Anhy 835' Heeb. 2990
Lans. 3065' SO 3097-3101 TD
5" @ 3097' 500A
P 54 bo 20 bwpd 1000 A
Comp. 12 bo 4 bwpd

COMPLETED

1951 O. W. D. D

2/7 Lans 3065'
5" @ 3097'
OTD 3101'
DD 3156' testing

2/21 Oil well TD 3156
Lans. 3065
5" @ 3097 OTD 3101
DD 3156 1000 A S/ 1 1/2 boph
Comp. 25 bopd

COMPLETED