

Map No. _____ Sec. 21 Twp. 15 R. 13W

Well No. 1 Karst


Co-op _____ Company _____

FIRST REPORT

Contractor _____

C S L SW SW

SECTION PLAT

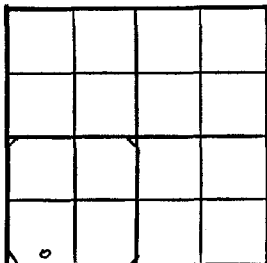

_____ Ft. from N. Line

330 _____ Ft. from S. Line

_____ Ft. from E. Line

660 _____ Ft. from W. Line

Russell County

Location X

RECORD

Cased _____ in. _____ ft.

Sand _____

Gas _____

Oil _____

Total Depth _____

PRODUCTION

1st 24 hrs. Nat. _____

1st 24 hrs. after shot _____

Gas _____ Cu. Ft.

Dry Hole _____

Abandoned _____

Date

JAN 8 1947 19 S. J. LEWIS Scout

Map No. _____ Sec. 21 Twp. 15 R. 13W

Well No. 1 Karst


Co-op _____ Company _____

COMPLETE

Contractor _____

C S L SW SW

SECTION PLAT

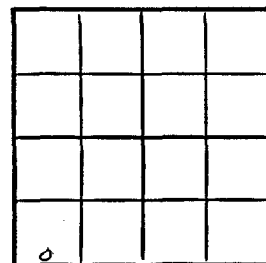

_____ Ft. from N. Line

330 _____ Ft. from S. Line

_____ Ft. from E. Line

660 _____ Ft. from W. Line

Russell County

Location _____

RECORD

Cased _____ in. _____ ft.

Sand _____

Gas _____

Oil _____

Total Depth _____

PRODUCTION

1st 24 hrs. Nat. _____

1st 24 hrs. after shot _____

Gas _____ Cu. Ft.

Dry Hole _____

Abandoned _____

Date

MAR 12 1947 19 S. J. LEWIS Scout

Russell County

Sec. 21 Twp. 15 R. 13

Well No. 1 Karst Farm

Co-op Company

Trapp Pool


Ft. from N. Line

330 Ft. from S. Line

Ft. from E. Line

660 Ft. from W. Line

C S L SW SW

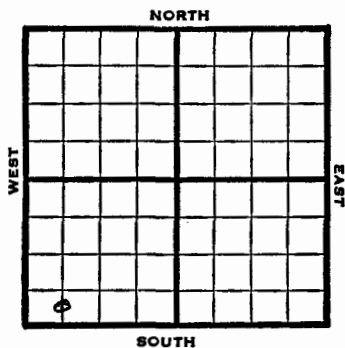

1947 Elev. 1377 REPORT

1/8 Location

1/15 8" @ 347
Drlg 1260'

1/21 Lans 3044
Drlg 3297'

1/30 Arb 3334
TD 3336'
5" @ 3334
RUST

2/5 TD 3336'
500 Acid
Swb 3 oil PH

2/12 " "

2/19 " "

2/26 " "

3/4 Pump 80 bbls oil a day

3/12 Arb 3334
5" @ 3334
Pump 25 oil & 43% W Pot

COMPLETED

KANSAS

Russell county

Section 21 Township 15 Range 13-W

Well No. #1, Karst

Company Co-op

