

KANSAS

Trapp Pool

Map No. _____ Sec. 22 Twp. 15 R. 13W

Well No. 4 Esfeld

Cities Service _____ Company

FIRST REPORT _____ Contractor

C S L NE NW

SECTION PLAT


990 Ft. from N. Line

Ft. from S. Line

660 Ft. from E. Line

Ft. from W. Line

Russell County

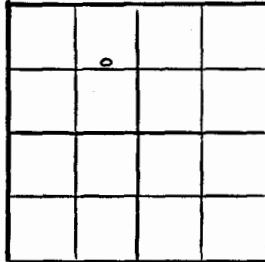

Location X

RECORD

Cased _____ in., _____ ft.

Sand _____

Gas _____

Oil _____

Total Depth _____

PRODUCTION

1st 24 hrs. Nat. _____

1st 24 hrs. after shot _____

Gas _____ Cu. Ft.

Dry Hole _____

Abandoned _____

Date

MAR 19 1947 19 S. J. LEWIS Scout

KANSAS

Trapp Pool

Map No. 173 Sec. 22 Twp. 15 R. 13W

Well No. 4 Esfeld

Cities Service _____ Company

ABANDONED

Contractor

C S L NE NW

SECTION PLAT


990 Ft. from N. Line

Ft. from S. Line

660 Ft. from E. Line

Ft. from W. Line

Russell County

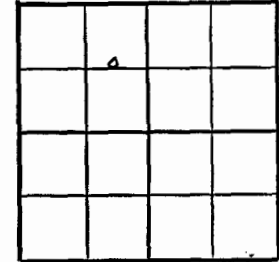

Location _____

RECORD

Cased _____ in., _____ ft.

Sand _____

Gas _____

Oil _____

Total Depth 2826

PRODUCTION

1st 24 hrs. Nat. _____

1st 24 hrs. after shot _____

Gas _____ Cu. Ft.

Dry Hole _____

Abandoned _____

Date

APR 9 1947 19 S. J. LEWIS Scout

Russell

Sec. 22 Twp. 15 R. 13-77

Well No. #4 Esfeld Farm

Cities Service

Company


Trapp Pool

990 Ft. from N. Line

Ft. from S. Line

660 Ft. from E. Line

Ft. from W. Line

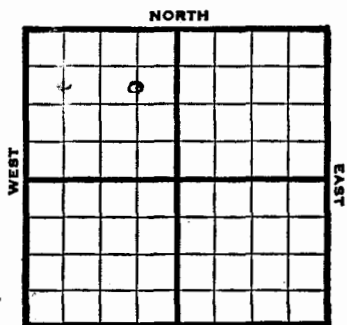

C S L NE NW Elev. 1869'

REPORT

1947

3/19 Location

3/25 8" @ 360'
Drlg 1535'

4/2 Drlg. 2830'

4/9 Lans 3059'
Arb 3346
TD 3376'

ABANDONED

Russell KANSAS

Section 22 Township 15 Range 13W

Well No. 4 Esfeld

Company Cities Service

Trapp

