

Trapp Pool

Map No. \_\_\_\_\_ Sec. 22 Twp. 15 R. 13W

Well No. 1 Esfeld "D"

B. & R Drlg. \_\_\_\_\_ Company

FIRST REPORT Contractor

NW SW NW

SECTION PLAT


\_\_\_\_\_ Ft. from N. Line

990 Ft. from S. Line

\_\_\_\_\_ Ft. from E. Line

330 Ft. from W. Line

Russell County

Location X

Rig up \_\_\_\_\_

Drilling and Remarks:

RECORD

Cased \_\_\_\_\_ in., \_\_\_\_\_ ft.

Sand \_\_\_\_\_

Gas \_\_\_\_\_

Oil \_\_\_\_\_

Total Depth \_\_\_\_\_

PRODUCTION

1st 24 hrs. Nat. \_\_\_\_\_

1st 24 hrs. after shot \_\_\_\_\_

Gas \_\_\_\_\_ Cu. Ft.

Dry Hole \_\_\_\_\_

Abandoned \_\_\_\_\_

Date

JUL 8 1948 19 S. J. LEWIS Scout

Trapp Pool

Map No. 72 Sec. 22 Twp. 15 R. 13W

Well No. 1 Esfeld "D"

B. & R Drlg. \_\_\_\_\_ Company

**ABANDONED** Contractor

NW SW NW

E. 1862  
SECTION PLAT


\_\_\_\_\_ Ft. from N. Line

290 Ft. from S. Line

\_\_\_\_\_ Ft. from E. Line

330 Ft. from W. Line

Russell County

Location \_\_\_\_\_

Rig up \_\_\_\_\_

Drilling and Remarks:

Lease 8074

Q 283351

RECORD

Cased \_\_\_\_\_ in., \_\_\_\_\_ ft.

Sand \_\_\_\_\_

Gas \_\_\_\_\_

Oil \_\_\_\_\_

Total Depth 3276

PRODUCTION

1st 24 hrs. Nat. \_\_\_\_\_

1st 24 hrs. after shot \_\_\_\_\_

Gas \_\_\_\_\_ Cu. Ft.

Dry Hole \_\_\_\_\_

Abandoned \_\_\_\_\_

Date

JUL 14 1948 19 S. J. LEWIS Scout

KANSAS

Russell



Sec. 22 Twp. 15 R. 13W

Well No. #1 Esfeld "D" Farm \_\_\_\_\_

B. & R. Drlg. Company \_\_\_\_\_

Trapp Pool


\_\_\_\_\_ Ft. from N. Line

990' Ft. from S. Line

\_\_\_\_\_ Ft. from E. Line

330' Ft. from W. Line

NW SW NE

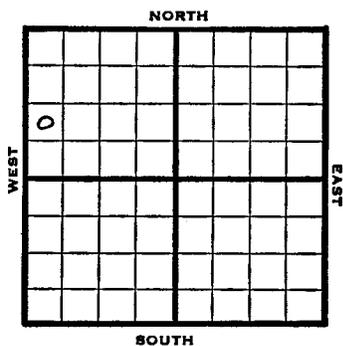


KANSAS Russell

Section 22 Township 15 Range 13-W

Well No. #1 Esfeld "D"

Company B & R<sup>D</sup> rlg.

Trapp Pool

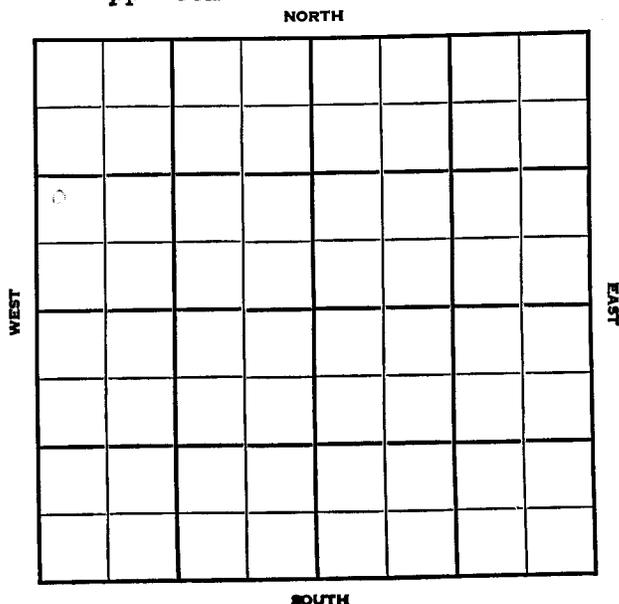

1948 Eli 1862' REPORT

7/8 Location

7/14 TD 3376'  
Lansing 3074'  
Arb. 3351'  
Abandoned  
~~ABANDONED~~