

Russell KANSAS

SEC. 22 TWP. 15 R. 13W ✓
 WELL NO. 7 Sellens "B" FARM

COMPANY Texas Company


CONTRACTOR Powell Drlg.
 Trapp Pool

_____ Ft. from N. Line

990 _____ Ft. from S. Line

_____ Ft. from E. Line

990 _____ Ft. from W. Line

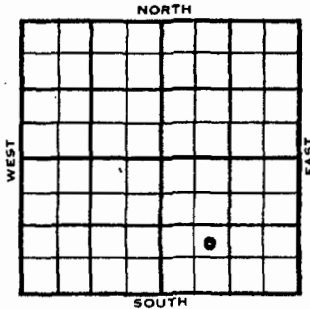

NE SW SE

1953	ELEVATION	REPORT
	1836'	

12/30 Spud 12-25-53
 10" @ 805'
 Drlg. 1855'

1954
 1/6 Tarkio 2426', Top 2701', Heeb 2930',
 Lans 3009'
 DST 3197-3209', 1 hr., 210' gas,
 32' HOCM, 960#
 Arb. 3284'
 TD 3289'
 7" @ 3286'

1/13 CO 3289' NS
 DD 3291 TD
 S/2½ boph 10 hrs.

1/20 P/3¼ BOPD

1/27 Spud 12-25-53
 Oil Well
 TD 3291'
 10" @ 805'
 Tarkio 2426', Top 2701', Heeb 2930',
 Lans 3009'

DX-78

OVER

1954

Information brought forward.

1/27

DST 3197'-3209' opn 1 hr, rec 210'
 gas, 32' hocm, 960# Arb 3284'
 TD 3289'
 7" @ 3286'
 CO to 3289'
 DD 3291'
 S/ 2½ boph 10 hr.
 P/ 3¼ bopd 500 A
 Comp 45 bopd.

COMPLETED

FORM 51

Russell

KANSAS

Section 22 Township 15 Range 13W

Well No. #7 Sellens "B"

Company Texas Company

