

Map No. 73 Sec. 22 Twp. 15 R. 13W

Map No. 433 Sec. 22 Twp. 15 R. 13W

Well No. 3 Sellens

Well No. 3 Sellens

Texas Company

Texas Company

FIRST REPORT

COMPLETED

Contractor

Contractor

C NW SE


SECTION PLAT

660 Ft. from N. Line

\_\_\_\_\_ Ft. from S. Line

\_\_\_\_\_ Ft. from E. Line

660 Ft. from W. Line

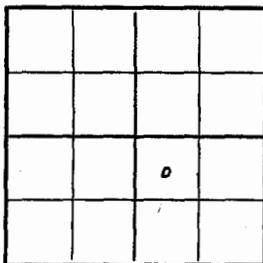

C NW SE


SECTION PLAT

660 Ft. from N. Line

\_\_\_\_\_ Ft. from S. Line

\_\_\_\_\_ Ft. from E. Line

660 Ft. from W. Line

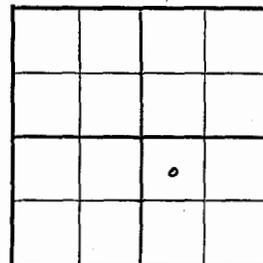

Sellens Pool

Sellens Pool

Location X

RECORD

Cased \_\_\_\_\_ in., \_\_\_\_\_ ft.

Sand \_\_\_\_\_

Gas \_\_\_\_\_

Oil \_\_\_\_\_

Total Depth \_\_\_\_\_

PRODUCTION

1st 24 hrs. Nat. \_\_\_\_\_

1st 24 hrs. after shot \_\_\_\_\_

Gas \_\_\_\_\_ Cu. Ft.

Dry Hole \_\_\_\_\_

Abandoned \_\_\_\_\_

Rig up \_\_\_\_\_  
Drilling and Remarks:

Location \_\_\_\_\_

RECORD

Cased \_\_\_\_\_ in., \_\_\_\_\_ ft.

Sand \_\_\_\_\_

Gas \_\_\_\_\_

Oil \_\_\_\_\_

Total Depth 3040

PRODUCTION

1st 24 hrs. Nat. \_\_\_\_\_

1st 24 hrs. after shot \_\_\_\_\_

Gas \_\_\_\_\_ Cu. Ft.

Dry Hole \_\_\_\_\_

Abandoned \_\_\_\_\_

Rig up \_\_\_\_\_  
Drilling and Remarks:

*Loss 2994  
7" @ 3000  
5000 acid  
Pump 490 Pst  
40:95*

Date

Date

NOV 24 1943 19 S. J. LEWIS Scout

JAN 12 1944 19 S. J. LEWIS Scout

Map No. \_\_\_\_\_ Sec. 22 Twp. 15 R. 13W

Well No. 3 Sellens

Texas \_\_\_\_\_ Company

**O.W.W.O.** Contractor

C NW SE

SECTION PLAT

660 Ft. from N. Line  
\_\_\_\_ Ft. from S. Line  
\_\_\_\_ Ft. from E. Line  
660 Ft. from W. Line



Russell County

Location \_\_\_\_\_

RECORD

Cased \_\_\_\_\_ in., \_\_\_\_\_ ft.  
Sand \_\_\_\_\_  
Gas \_\_\_\_\_  
Oil \_\_\_\_\_  
Total Depth \_\_\_\_\_

PRODUCTION

1st 24 hrs. Nat. \_\_\_\_\_  
1st 24 hrs. after shot \_\_\_\_\_  
Gas \_\_\_\_\_ Cu. Ft.  
Dry Hole \_\_\_\_\_  
Abandoned \_\_\_\_\_

Rig up \_\_\_\_\_  
Drilling and Remarks:

Lans. 2994  
7" @ 3000  
OTD 3040  
DD 3100 TD  
Pump 388 bo  
trace water  
24 hrs.

Date

JUN 21 1950 19 J. E. TYRA Scout

Map No. \_\_\_\_\_ Sec. 22 Twp. 15 R. 13W

Well No. 3 Sellens


Texas \_\_\_\_\_ Company

Contractor

C NW SE

SECTION PLAT

~~660~~ Ft. from N. Line  
~~330~~ Ft. from S. Line  
~~157~~ Ft. from E. Line  
660 Ft. from W. Line

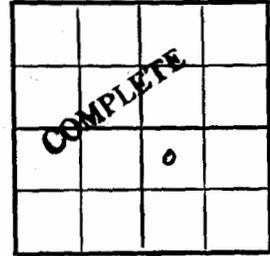

Russell County

Location \_\_\_\_\_

RECORD

Cased \_\_\_\_\_ in., \_\_\_\_\_ ft.  
Sand \_\_\_\_\_  
Gas \_\_\_\_\_  
Oil \_\_\_\_\_  
Total Depth 3100

PRODUCTION

1st 24 hrs. Nat. \_\_\_\_\_  
1st 24 hrs. after shot \_\_\_\_\_  
Gas \_\_\_\_\_ Cu. Ft.  
Dry Hole \_\_\_\_\_  
Abandoned \_\_\_\_\_

Rig up \_\_\_\_\_  
Drilling and Remarks:

Lans. 2994  
7" @ 3000  
OTD 3040  
DD to 3100  
Comp. 388 bopd

Date


JUN 28 1950 19 J. E. TYRA Scout

KANSAS

Russell

Sec. 22 Twp. 15 R. 13-W

Well No. #3 Sellens Farm \_\_\_\_\_  
 \_\_\_\_\_ Texas Company \_\_\_\_\_

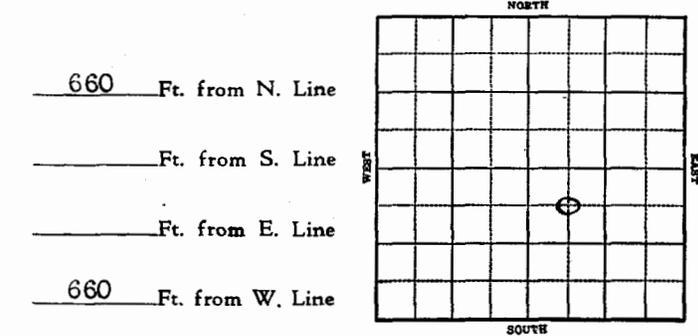

KANSAS


Russell

**O.W.W.O.**

Section 22 Township 15 Range 13-W

Well No. #3 Sellens

Company Texas

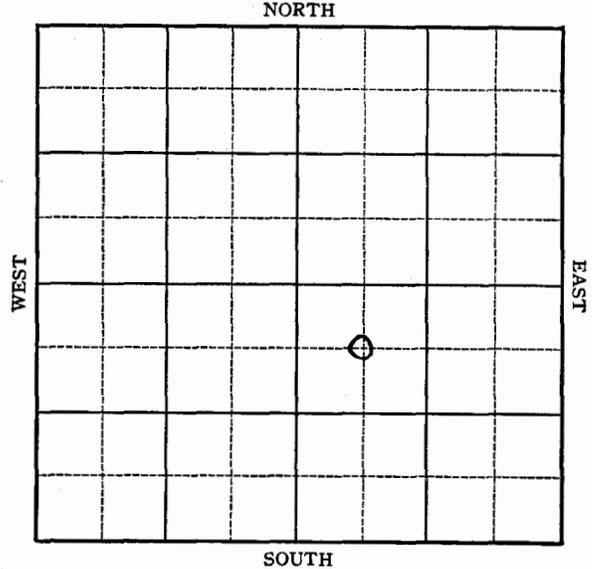

1943

**REPORT**

11/24 Location.  
 12/1 Drlg. 377'  
 12/8 10" @ 375'  
 Drlg. 1292'  
 12-15 Drlg. 2742'  
 Anhy 780'  
 12/22 Lans. 2994 @ 3024 TD  
 7" @ 3000  
 Rust  
 12/29 CO  
 1944  
 1-5 TD 3040  
 200' oil 6 hrs. 5000 acid  
 1/12 7" @ 3000  
 Lans 2994  
 TD 3040  
 5000 acid  
 Pump 490 Pot.  
 Gravity 40  
 1950  
 6/21 Lans. 2994'  
 7" @ 3000'  
 OTD 3040  
 DD 3100 TD  
 Pump 388 BO trace wtr  
 24 hrs. **FIRST REPORT**  
**COMPLETED**

**O.W.W.O.**