FORM 275 FOR SALE BY KANSAS BLUE PRINT CO.


County Russell State Kansas

Sec. 22 (Blk. Twp.) 15 (Sur. Rge.) 13W Map No.

Operator Murfin Drlg.

Well No. 3 Farm Sellens

Elev. Location E/2 E/2 SW

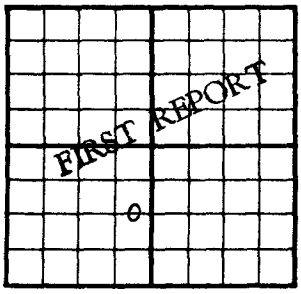

1320 Ft. From S Line SW

330 Ft. From E Line Quarter

1st. Report APR 16 1952

Completion

Remarks

Spudding Date

Drlg. Data

MI

J. G. McGEHEE

FORM 275 FOR SALE BY KANSAS BLUE PRINT CO.


County Russell State Kansas

Sec. 22 (Blk. Twp.) 15 (Sur. Rge.) 13W Map No.

Operator Murfin Drlg.

Well No. 3 Farm Sellens

Elev. 1838 Location C E L E½ SW

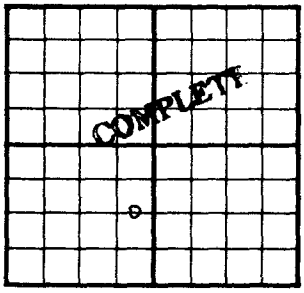

1320 Ft. From S Line SW

330 Ft. From E Line Quarter

1st. Report

Completion MAY 28 1952

Remarks

Spudding Date 4-15-52

Drlg. Data Oil well TD 3293

8" @ 224 Top. 2707 KC 3026 Arb. 3290

TD 3293 5" @ 3290 CO to 3279

32/ 3104-12 3000 A Comp. 40 bopd

J. G. McGEHEE

FORM 252-B
10M 8-51 TPCO.

Russell KANSAS

Sec. 22 Twp. 15 R. 13W

Well No. #3 Sellens Farm

Murfin Drlg. Company

Contractor


Ft. from N. Line

1320' Ft. from S. Line

330' Ft. from E. Line

Ft. from W. Line

E/2 E/2 SW

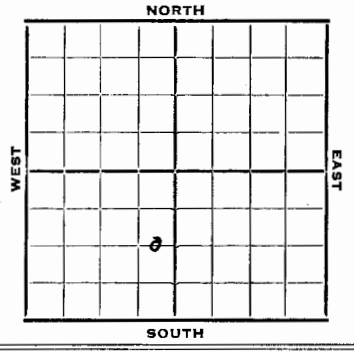

1952	Elev. 1838' REPORT
4/16	MI
4/23	8" @ 224' Topeka 2707' Drlg. 3035'
4/30	KC 3026 Arb. 3290 RTD 3293 5" @ 3290' WOCT
5/7	WOCT
5/14	"
5/21	CO 3279'
5/28	Spud 4-15-52 Oil well TD 3293' 8" @ 224 Top. 2707' KC 3026' Arb. 3290' TD 3293' 5" @ 3290 CO to 3279 32/3104-12 3000 A Comp. 40 BOPD COMPLETED

FORM 51 25M 3-49 PETROL Russell KANSAS

Section 22 Township 15 Range 13W

Well No. #3 Sellens

Company Murfin Drlg.

