



Russell KANSAS

Sec. 22 Twp. 15 R. 13W

Well No. #4 Sellens Farm

Murfin Drlg. Company

Contractor


Ft. from N. Line

990 Ft. from S. Line

990 Ft. from E. Line

Ft. from W. Line

NW SE SW

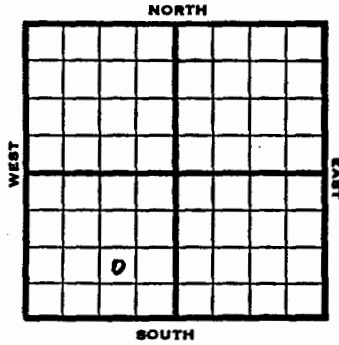


Russell KANSAS

Section 22 Township 15 Range 13W

Well No. #4 Sellens

Company Murfin Drlg.

NORTH

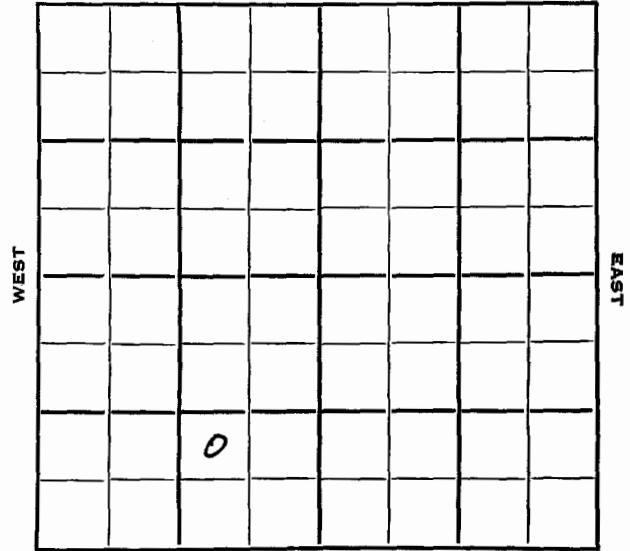

SOUTH

1953 Elev. 1856' REPORT

7/29 Spud 7-30-53 Location

8/5 Drlg. 940'

8/12 8" @ 940 Tarkio 2406 Top 2747' Heeb 2974 Tor 2993 Br li 3053 Arb. 3321 RTD 3322 5" @ 3321

9/16 Spud 7-30-53 Oil Well TD 3322' 8" @ 940 Tarkio 2406, Top 2747, Heeb 2974, Tor 2993, Br line 3053, Lans 3070, Arb 3321 TD 3322' 5" @ 3321, CO to 3295, 12/3236-40, 20/3194-3204 SSO, 2000A S/2 boph 3 hrs., 20/3130-40, 5 boph 2 hrs., 3000A Comp. 25 bopd

COMPLETED