

Russell KANSAS

Sec. 22 Twp. 15 R. 13W

Well No. #3 J. W. Sellens "B" Farm

Eddie Riggs Company

Prime Contractor
Trapp Pool


Ft. from N. Line

990' Ft. from S. Line

990' Ft. from E. Line

Ft. from W. Line

NW SE SE

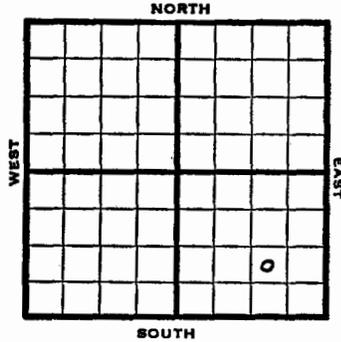


Russell KANSAS

Section 22 Township 15 Range 13W

Well No. #3 J. W. Sellens "B"

Company Eddie Riggs

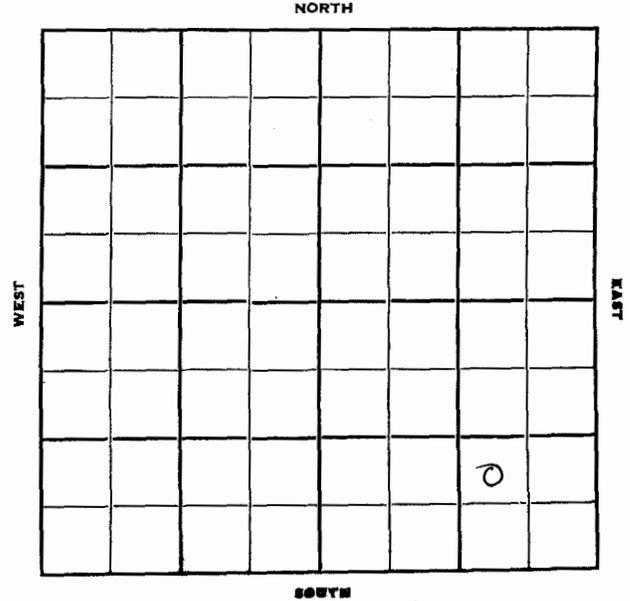

1950	Elev 1839	REPORT
9/13	Spud 9-5-50	
	8" @ 245'	
	Anhy 795'	
	Drlg. 2988'	
10/25	8" @ 245	
	Anhy 795	Top 2650
	Heeb 2938	Douglas 2954
	Br Line 2992	Lans 3002
	Cong 3276	Arb 3295-3314
	5" @ 3314	
	CO to 3250	
	24/3098-3106	
	SO 3000 A	
	S/14 bopd	
	TD 3314	
	Comp 60 bopd	
	Completed	
	COMPLETED	