

Kansas

Map No. _____ Sec. 23 Twp. 15 R. 13W

Well No. 1 Berrick
Jones, Shelborne & Farmer Company

Contractor

NW NE NW

SECTION PLAT

330 Ft. from N. Line
_____ Ft. from S. Line
990 Ft. from E. Line
_____ Ft. from W. Line



Russell County

Location _____
Rig up X
Drilling and Remarks:

RECORD
Cased _____ in., _____ ft.
Sand _____
Gas _____
Oil _____
Total Depth _____

PRODUCTION
1st 24 hrs. Nat. _____
1st 24 hrs. after shot _____
Gas _____ Cu. Ft.
Dry Hole _____
Abandoned _____

Date

JUN 28 1950 19 J. E. TYRA Scout

Kansas

Map No. _____ Sec. 23 Twp. 15 R. 13W


Well No. 1 Berrick
Jones, Shelborne & Farmer Company

Contractor

NW NE NW

E1. 1813
SECTION PLAT

330 Ft. from N. Line
_____ Ft. from S. Line
990 Ft. from E. Line
_____ Ft. from W. Line

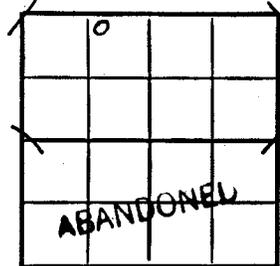

Russell County

Location _____
Rig up _____
Drilling and Remarks:

8 5/8" @ 150
Anhy 785
Topeka 2877
Heeb. 2924
Dodge 2941
Br. lime 3004

RECORD
Cased _____ in., _____ ft.
Sand _____
Gas _____
Oil _____
Total Depth 3348

PRODUCTION
1st 24 hrs. Nat. _____
1st 24 hrs. after shot _____
Gas _____ Cu. Ft.
Dry Hole _____
Abandoned _____

Date

JUL 12 1950 19 J. E. TYRA Scout

Russell KANSAS

Sec. 23 Twp. 15 R. 13W ✓

Well No. #1 Berrick Farm

Jones, Shelborne & Farmer Company

Contractor


330' Ft. from N. Line

Ft. from S. Line

990' Ft. from E. Line

Ft. from W. Line

NW NE NW

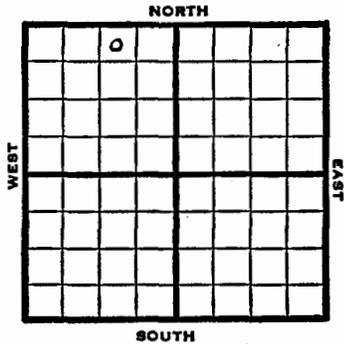

KANSAS


Russell

Section 23 Township 15 Range 13-W

Well No. #1 Berrick

Company Jones, Shelborne & Farmer

NORTH

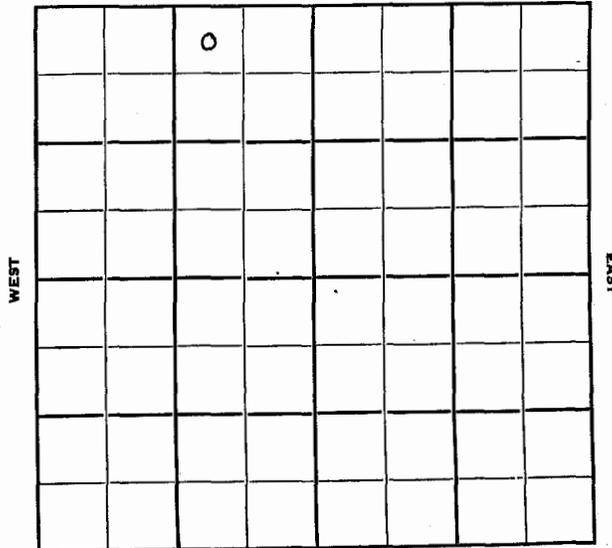

SOUTH

1950

Elev 1813

REPORT

6/28 Rig up
 7/12 8 5/8" @ 150
 Anhy 785
 Heeb 2924
 Br Line 3004
 Arb 3290
 TD 3348
 D&A

Topoka 2677
 Dodge 2941
 Lans 3015