

Russell KANSAS ✓

Sec. 23 Twp. 15 R. 13W

Well No. #1 Berrick Farm

Jones, Shelburne & Farmer Company

J-S-F Contractor


Ft. from N. Line

990 Ft. from S. Line

330 Ft. from E. Line

Ft. from W. Line

NE SE SW

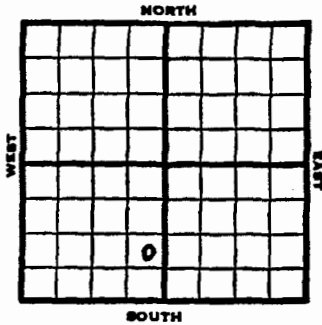

#1 Berrick
(Information Brought Forward)

1953
3/25

Anhy 784
10" @ 784
Tarkio 2370
25 goph
8" @ 2085
Top 2710, Lans 3025, Arb.
3295
TD 3320 wtr
5" @ 2421,
20/2372-77, FU 300' wtr.
30 mins., CO to 2395
20/2374-79, 5 goph, Hydro
Comp. 35 bopd 25 bw

COMPLETED

1952 Elev. 1821' REPORT

12/28	Location
12/8	" "
1/1	Location
1/8	Location
1/22	"
1/29	"
2/5	15" @ 45 Drlg. 140'
2/12	12" @ 420 Anhy 784' 10" @ 784 Drlg. 1000
2/19	Drlg. 2065'
2/26	Tarkio 2370' 25 GOPH 8" @ 2085 Top 2710' Drlg. 2750'
3/12	Lans. 3025' Drlg. 3280'
3/19	Arb. 3295' TD 3320' wtr. 5" @ 2421 20/2372-77 FU 300' wtr 30 mins to re-cement.
3/25	Spud 1-31-53 Oil Well TD 3320 15" @ 46 12" @ 420

OVER

FORM 51

Russell

KANSAS

Section 23 Township 15 Range 13W

Well No. 1 - Berrick

Company Jones, Shelburne & Farmer

