

Map No. _____ Sec. 23 Twp. 15 R. 13WWell No. 4 Berrick_____
E. Adair Company_____
Adair Contractor

SW SE SE

FIRST REPORT
SECTION PLAT

Ft. from N. Line330 Ft. from S. Line990 Ft. from E. Line_____
Ft. from W. Line

Russell County

Location _____

Rig up _____

Drilling and Remarks:

8" @ 206

RECORD

Cased _____ in., _____ ft.

Sand _____

Gas _____

Oil _____

Total Depth _____

PRODUCTION

1st 24 hrs. Nat. _____

1st 24 hrs. after shot _____

Gas _____ Cu. Ft.

Dry Hole _____

Abandoned _____

Date

NOV 30 1949 19S. J. LEWIS ScoutMap No. _____ Sec. 23 Twp. 15 R. 13WWell No. 4 Berrick_____
E. Adair Company_____
Contractor

SW SE SE

E! 1784
SECTION PLAT

Ft. from N. Line330 Ft. from S. Line990 Ft. from E. Line_____
Ft. from W. Line

Russell County

Location _____

Rig up _____

Drilling and Remarks:

8" @ 2065" @ 3238Hub 2883Br L 2964Lana 2977Ant 3237P-235 B.O.P.D

Date

JAN 25 1950

19

J. E. TYRA

Scout


Russell

KANSAS

Sec. 23 Twp. 15 R. 13W

Well No. #4 Berrick Farm

E. Adair
Trapp Pool (Adair, Contr.) Company

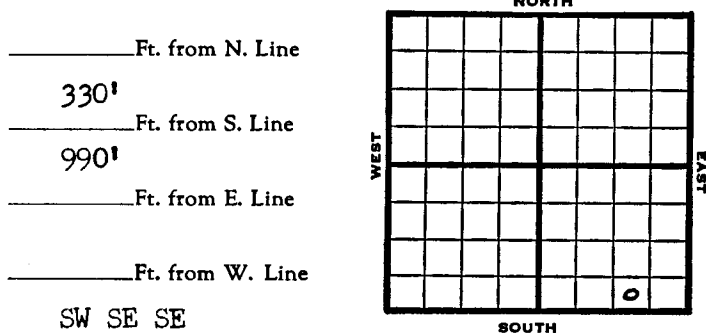

1949 Elv. 1784' REPORT

11/30 8" @ 206
12/7 Lansing 2977'
Drlg 3064'

12/14 Arbuckle 3237
TD 3240'
5" @ 3238'

12/21 "
12/28 "

1950

1/25 8" @ 206'
5" @ 3238'
Heab 2883'
Bv L 2964'
Lans 2977'
Arb 3237'
P 235 BOPD
TD 3243'

COMPLETED

KANSAS

Russell

Section 23 Township 15 Range 13-W

Well No. #4 Berrick

Company E Adair
Trapp Poo;

