

Trapp Pool

Map No. _____ Sec. 23 Twp. 15 R. 13W

Well No. 1 Berrick


E. Adair Company

FIRST REPORT Contractor

SE/C

SECTION PLAT

_____ Ft. from N. Line
200 Ft. from S. Line
200 Ft. from E. Line
_____ Ft. from W. Line

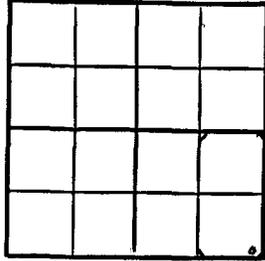

Russell County

Location X

Rig up _____

Drilling and Remarks:

RECORD

Cased _____ in., _____ ft.

Sand _____

Gas _____

Oil _____

Total Depth _____

PRODUCTION

1st 24 hrs. Nat. _____

1st 24 hrs. after shot _____

Gas _____ Cu. Ft.

Dry Hole _____

Abandoned _____

Date

MAR 16 1949

19

S. J. LEWIS

Scout

Russell County Kansas State

Map No. K 73 Sec. 23 Twp. 15 R. 13W

Well No. 1 Berrick


E. Adair Company

COMPLETE Contractor

SE/C

E11922
SECTION PLAT

_____ Ft. from N. Line
200 Ft. from S. Line
200 Ft. from E. Line
_____ Ft. from W. Line

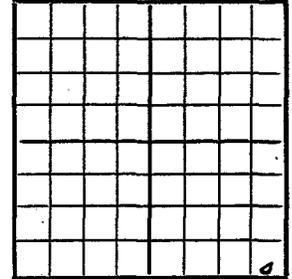

Trapp Pool

Remarks:

OK 3327
5" 0325
W 03327

Pay 2030000x

4036

Date

JUN 15 1949

Scout

KANSAS Russell

Sec. 23 Twp. 15 R. 13W ✓

Well No. #1 Berrick Farm

E. Adair Company

Trapp Pool


_____ Ft. from N. Line

200' Ft. from S. Line

200' Ft. from E. Line

_____ Ft. from W. Line

SE/C

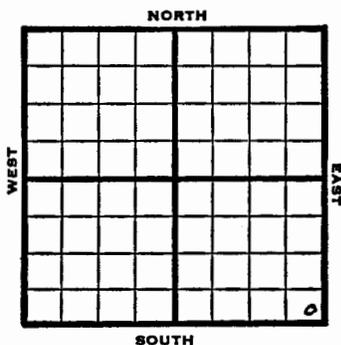

1949 Elev 1872' REPORT

- 3/16 Location
- 3/23 "
- 3/30 "
- 4/6 "
- 4/12 "
- 4/20 Cellar & Pits
- 4/27 "
- 5/4 "
- 5/10 Moving in Rotary
- 5/18 8" @ 227'
D rlg 2453'
- 5/25 Lans. 3065'
Arb. 3329'
TD 3333
5" @ 3333'
- 6/1 TD 3337-
Swb 4 bbls oil PH 4 hrs.
- 6/7 "
- 6/15 Arb. 3327'
5" @ 3328'
TD 3337'
Pump 203 Oil Pot
40" Gr.
Comp

COMPLETED

KANSAS

Russell

Section 23 Township 15 Range 13W

Well No. 1 Berrick

Company E. Adair

Trapp Pool
NORTH

