

Map No. \_\_\_\_\_ Sec. 24 Twp. 15 R. 13W

Well No. 3 Berrick

E. Adair \_\_\_\_\_ Company

Contractor

NE NW SW

FIRST REPORT  
SECTION PLAT

330 Ft. from N. Line

\_\_\_\_\_ Ft. from S. Line

\_\_\_\_\_ Ft. from E. Line

990 Ft. from W. Line


Russell County

Location \_\_\_\_\_

Rig up \_\_\_\_\_

Drilling and Remarks:

R U R

RECORD  
Cased \_\_\_\_\_ in., \_\_\_\_\_ ft.

Sand \_\_\_\_\_

Gas \_\_\_\_\_

Oil \_\_\_\_\_

Total Depth \_\_\_\_\_

PRODUCTION

1st 24 hrs. Nat. \_\_\_\_\_

1st 24 hrs. after shot \_\_\_\_\_

Gas \_\_\_\_\_ Cu. Ft.

Dry Hole \_\_\_\_\_

Abandoned \_\_\_\_\_

Date

JUL 6 1949 19

S. J. LEWIS Scout

Map No. K73 Sec. 24 Twp. 15 R. 13W

Well No. 3 Berrick

E. Adair \_\_\_\_\_ Company

COMPLETE

Contractor

NE NW SW

E11774  
SECTION PLAT

330 Ft. from N. Line

\_\_\_\_\_ Ft. from S. Line

\_\_\_\_\_ Ft. from E. Line

990 Ft. from W. Line


Russell County

Location \_\_\_\_\_

Rig up \_\_\_\_\_

Drilling and Remarks:

*At 13249*

*5" @ 325'*

*Prof.*

*5000 cu*

*Prof 76 oil + 15 7/8*

*Prof*

*40 2/3*

RECORD  
Cased \_\_\_\_\_ in., \_\_\_\_\_ ft.

Sand \_\_\_\_\_

Gas \_\_\_\_\_

Oil \_\_\_\_\_

Total Depth *822*

PRODUCTION

1st 24 hrs. Nat. \_\_\_\_\_

1st 24 hrs. after shot \_\_\_\_\_

Gas \_\_\_\_\_ Cu. Ft.

Dry Hole \_\_\_\_\_

Abandoned \_\_\_\_\_

Date

SEP 14 1949 19

S. J. LEWIS Scout



O. W. D. D Russell

KANSAS



Sec. 24 Twp. 15 R. 13W

Well No. #3 Berrick Farm

~~B. Adair Kewanee Oil~~ Company

Trapp Pool


330' Ft. from N. Line

\_\_\_\_\_ Ft. from S. Line

\_\_\_\_\_ Ft. from E. Line

990' Ft. from W. Line

NE NW SW

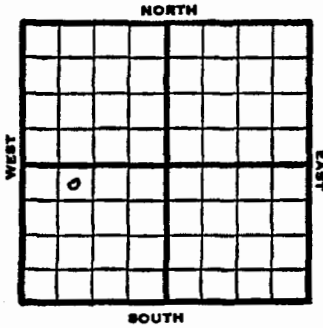

1951  
7/11

O. W. D. D

OWDD for SWD  
Arb. 3249' OTD 3253' was Lans prod  
DD 3419' TD

7/25

SWD well TD 3419'  
Arb. 3249' OTD 3253' DD 3419'  
1000 A  
Comp. for SWD well

**ABANDONED**

1949	Elev 1774'	REPORT
7/6		RUR
7/12		8" set 208' Drlg 2270'
7/20		Lansing 2971' Arb. 3249' TD 3252 5" @ 3251'
7/27		"
8/3		TD 3253' PB 3050'
8/10		"
8/17		"
8/24		"
8/31		"
9/7		"
9/14		TD 3252' Arb. 3249' 5" @ 3251' Perf 500 acid Pump 76 oil / 15% W Pot 40 <sup>g</sup> Gr. Comp
		<b>COMPLETED</b>
		<b>OVER</b>

