

Russell

KANSAS

Sec. 24 Twp. 15 R. 13W

Well No. #7 Berrick Farm

Kewanee Oil Company

Contractor

Trapp Pool


Ft. from N. Line

330' Ft. from S. Line

Ft. from E. Line

330' Ft. from W. Line

SW SW SW

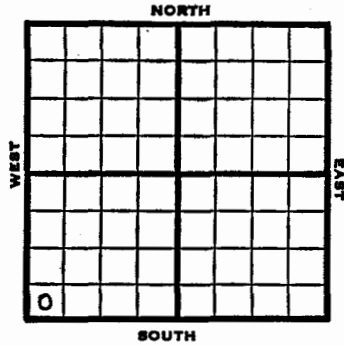


Russell

KANSAS

Section 24 Township 15 Range 13 W

Well No. #7 Berrick

Company Kewanee Oil

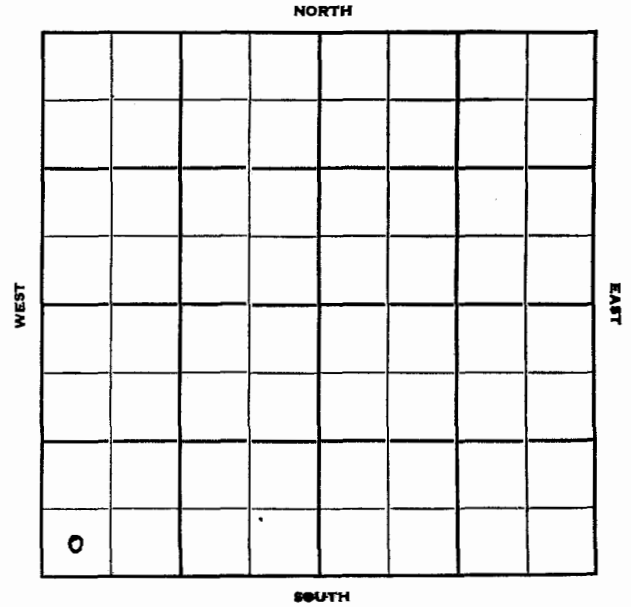

1951 Elev. 1856' REPORT

1/31 Drlg.

2/21 Spud 2-1-51
D & A TD 3360
8" @250

Anhy 820 Heeb. 2960 Br. lime 3041
Lans. 3053

Cored 3131-48 rec. 4' lime
Soft 3134-54 Cong. 3318 Arb. 3345-
60 TD
D & A

ABANDONED