

County **Russell** State **Kansas**
 Sec. **24** (Blk. (Twp.)) **15** (Sur. (Rge.)) **15W** Map No.
 Operator **Kewanee**
 Well No. **11** Farm **Berrick**
 Elev. _____ Location **NW NW SW**

330 Ft. From **W** Line **SW**
330 Ft. From **W** Line Quarter
 Ist. Report **MAR 5 1952**
 Completion _____
 Remarks _____
Gross - Contr.
 Spudding Date _____

Drlg. Data _____
Location _____

J. G. McGEHEE

County **Russell** State **Kansas**
 Sec. **24** (Blk. (Twp.)) **15** (Sur. (Rge.)) **1 SW** Map No.
 Operator **Kewanee Oil**
 Well No. **11** Farm **Berrick**
 Elev. **1777** Location **NW NW SW**

330 Ft. From **N** Line **SW**
330 Ft. From **W** Line Quarter
 Ist. Report _____
 Completion **APR 2 1952**
 Remarks _____
Gross D.lg. - Contr.
 Spudding Date **3-7-52**

Drlg. Data **D & A** **TD 3258**
8" @ 245 Heeb. 2386 Dodge 2907
 Er. line 2967 Lans. 2976 DST 3022-74
 open 1 hr. Rec. 90' mud Arb. 3245
 TD 3258 **5" @ 3232** DP to 3230
 20/ 3184-88 HFW PB 3154 12/ 3140-43
 20/ 3114-18 dry 500 A 12/ 3007-10
 500 A HFW
 D & A

J. G. McGEHEE

Russell

KANSAS

Sec. 24 Twp. 15 R. 13W

Well No. #11 Berrick Farm

Kewanee Company

Gross Contractor


330 Ft. from N. Line

Ft. from S. Line

Ft. from E. Line

330 Ft. from W. Line

NW NW SW

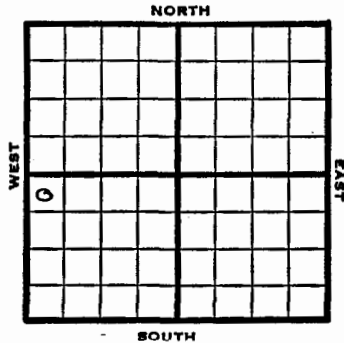


KANSAS

Section 24 Township 15 Range 13W

Well No. #11 Berrick

Company Kewanee

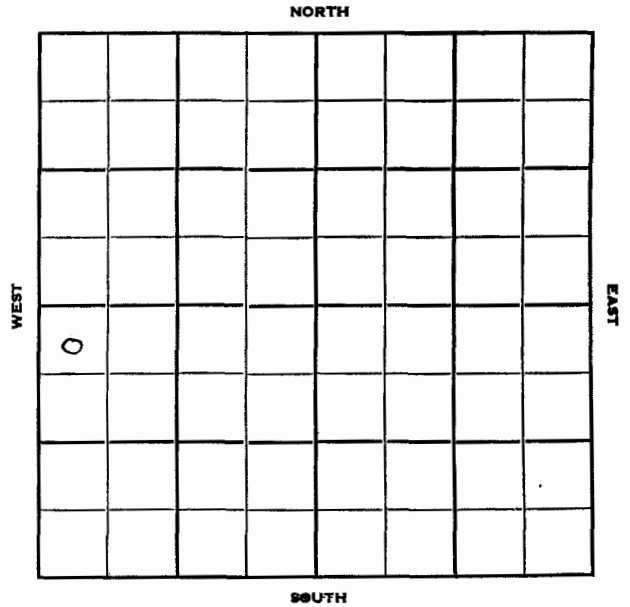

1952 Elev. 1777' REPORT

3/5 Location
 3/11 8" @ 245'
 Drlg. 615'

3/19 Heeb. 2886 Doège 2907
 Br Li 2967 Lans. 2976
 DST 3022-74 1 hr. 90' m
 Arb. 3245 RTD 3258
 5" @

4/2 Spud 3-7-52 D&A TD 3258
 8" @ 245 Heeb. 2886
 Dodge 2907 Br line 2967
 Lans. 2976
 DST 3022-74 opn 1 hr. Rec. 90' mud
 Arb 3245 TD 3258
 5" @ 3232 DP to 3230
 20/3184-88 HFW PB 3154 12/3140-43
 20/3114-18 dry 500 A 12/3007-10
 500 A HFW D&A

ABANDONED