


County **Russell** State **Kansas**
 Sec. **24** (Blk. Twp.) **15** (Sur. Rge.) **13W** Map No.
 Operator **E. H. Adair**
 Well No. **1** Farm **Luerman**
 Elev. **1852** Location **SW SE SE**

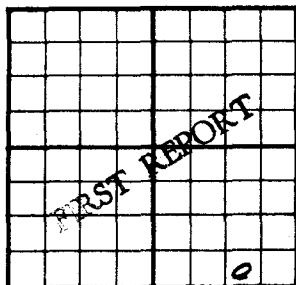


350 Ft. From **S** Line **SE**
990 Ft. From **E** Line Quarter
 1st. Report **APR 30 1952**
 Completion
 Remarks **Adair - Contr.**
 Spudding Date **4-26-52**

Drlg. Data **Semi Wildcat**

8" @ 255 Drlg. 1485

J. G. McGEHEE

County **Russell** State **Kansas**
 Sec. **24** (Blk. Twp.) **15** (Sur. Rge.) **13W** Map No.
 Operator **E. H. Adair**
 Well No. **1** Farm **Luerman**
 Elev. **1852** Location **SW SE SE**

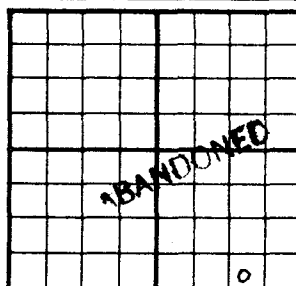

330 Ft. From **S** Line **SE**
990 Ft. From **E** Line Quarter
 1st. Report
 Completion **MAY 14 1952**
 Remarks **Semi Wildcat**
Adair - Contr.
 Spudding Date **4-26-52**

Drlg. Data **D & A TD 3382**

8" @ 255 Howard 2641 Top. 2716

Heeb. 2953 Dodge 2971 Br. line 3036

Lans. 3045 Cong. 3308 Arb. 3361

TD 3382

D & A

J. G. McGEHEE

Russell KANSAS

Sec. 24 Twp. 15 R. 13 W

Well No. # 1 Luerman Farm

E. H. Adair Company

Adair Contractor

Semi-Wildcat


Ft. from N. Line

330 Ft. from S. Line

990 Ft. from E. Line

Ft. from W. Line

SW SE SE

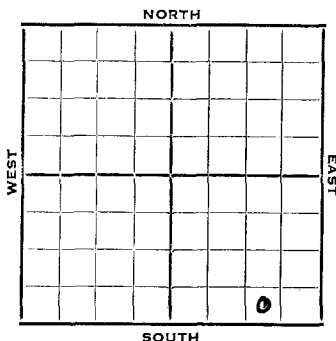


KANSAS

Section 24 Township 15 Range 13 W

Well No. #1 Luerman

Company E. H. Adair

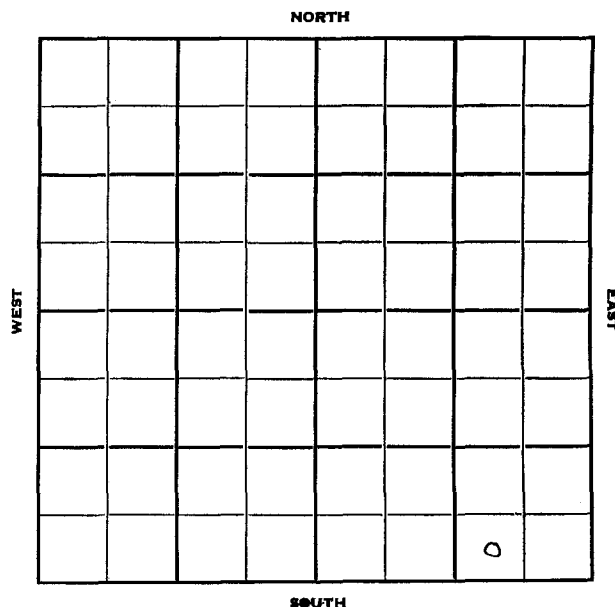

1952 Elev. 1852' REPORT

4/30 Spud 4-26-52
8" @ 255'
Drlg. 1485'

5/7 Howard 2641' Topeka 2716' Heeb 2953'
Dodge 2971' Br li 3036' Lans. 3045'
Drlg. 3224'

5/14 Spud 4-26-52
D&A TD 3382
8" @ 255 Howard 2641 Top 2716
Heeb. 2953 Dodge 2971 Br lime 3036
Lans. 3045 Cong. 3308 Arb. 3361
TD 3382 D&A

ABANDONED