

Russell

KANSAS
Map No. 73 Sec. 24 Twp. 15 R. 13W
Well No. 1 Luerman


Nadel & Gussman Company

FIRST REPORT

Contractor

SE NE

SECTION PLAT

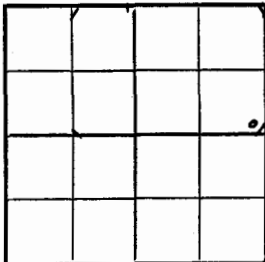

Ft. from N. Line

330 Ft. from S. Line330 Ft. from E. Line

Ft. from W. Line

Sellens Pool

Location

Rig up

Drilling and Remarks:

Rotary

Continental

farm-out

RECORD

Cased _____ in., _____ ft.

Sand _____

Gas _____

Oil _____

Total Depth _____

PRODUCTION

1st 24 hrs. Nat. _____

1st 24 hrs. after shot _____

Gas _____ Cu. Ft.

Dry Hole _____

Abandoned _____

Date

DEC 22 1943

19

S. J. LEWIS Scout

Russell

KANSAS
Map No. 73 Sec. 24 Twp. 15 R. 13W
Well No. 1 Luerman


Nadel & Gussman Company

ABANDONED

Contractor

SE NE

SECTION PLAT

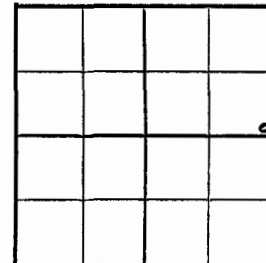

Ft. from N. Line

330 Ft. from S. Line330 Ft. from E. Line

Ft. from W. Line

Sellens Pool Cont'l farm-out

Location

Rig up

Drilling and Remarks:

*Car 8328**5 "8328"**Water*

RECORD

Cased _____ in., _____ ft.

Sand _____

Gas _____

Oil _____

Total Depth *3344*

PRODUCTION

1st 24 hrs. Nat. _____

1st 24 hrs. after shot _____

Gas _____ Cu. Ft.

Dry Hole _____

Abandoned _____

Date

JAN 19 1944


19

S. J. LEWIS Scout

Sec. 24 Twp. 15 R. 13-W

Well No. #1 Luerman Farm

Nadel & Gussman Company

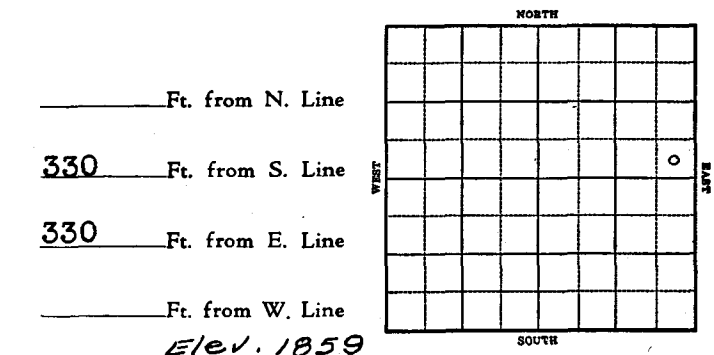

1943 REPORT

12-22 Rotary
Continental farm-out

12/29 8" @ 219 Drlg. 1790'

1944

1-5 Anhy 806
Drlg 2926'

1-12 Lans 3032
Arb 3323-27 TD
SSO 5" @ 3327 RUST

1/19 5" @ 3327
Arb 3323
TD 3344'
Water

ABANDONED

Section 24 Township 15 Range 13W

Well No. #1 Luerman

Company Nadel & Gussman

Sellens Pool

