


County Russell State Kansas
 Sec. 24 (Blk. Twp.) 15 (Sur. Rge.) 13W Map No.
 Operator Kewanee Oil
 Well No. 4 Farm Piester "B"
 Elev. _____ Location SE NE SW

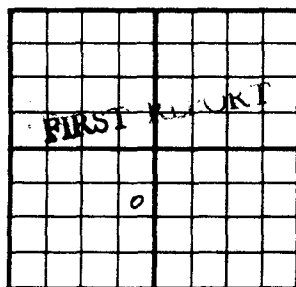


990 Ft. From N Line SW
330 Ft. From E Line Quarter
 1st. Report SEP 2 1953
 Completion _____
 Remarks _____
Prime Drlg. - Contr.
 Spudding Date 8-26-53

Drlg. Data Trapp Pool

8" @ 271 Anhy 795 drlg. 2172

J. G. McGEHEE

County Russell State Kansas
 Sec. 24 (Blk. Twp.) 15 (Sur. Rge.) 13W Map No.
 Operator Kewanee Oil
 Well No. 4 Farm Piester "B"
 Elev. 1843 Location SE NE SW

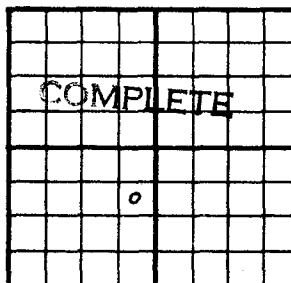

990 Ft. From N Line SW
330 Ft. From E Line Quarter
 1st. Report _____
 Completion SEP 30 1953
 Remarks Trapp Pool
Prime Drlg. - Contr.
 Spudding Date 8-26-53

Drlg. Data Oil well TD 3340

8" @ 271 Anhy 795 Heeb. 2950

Er. line 3030 KC 3039 Cong. 3302

TD 3340 5" @ 3257 CO to 3211

16/ 3191-95 SSO 1000 A S/ 1 3/4 bwph

3 hr. 3/4 bwph 4 hr. SP 3184

20/ 3101-11 40/ 3111-21 SO & Wtr.

1000 A S/ 1 boph 1 bw 3000 A

1 boph 3 1/2 bw P/ 19 bo 94 bw 15 hr.

Comp. 7 bopd 26 bw

J. G. McGEHEE

Russell KANSAS ✓


Sec. 24 Twp. 15 R. 13 WWell No. # 4 Piester "B" Farm _____Kewanee Oil Company _____Prime Drlg. Contractor _____Trapp Pool990 Ft. from N. Line

Ft. from S. Line _____

330 Ft. from E. Line

Ft. from W. Line _____

SE NE SW

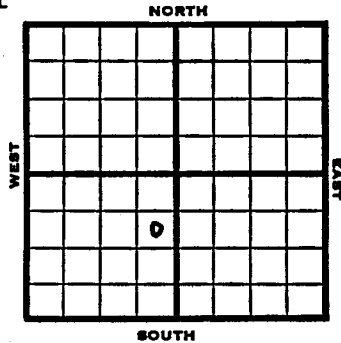

1953 Elev. 1843' REPORT

9/2 Spud 8-26-53
8" @ 271 Anhy 795
Drlg. 2172'

9/9 N.R.

9/16 NR

9/23 "

9/30 Spud 8-26-53 Oil well TD 3340
8" @ 271 Anhy 795 Heeb 2950
Br line 3030 KC 3039 Cong 3302
TD 3340 5" @ 3257 CO to 3211
16/3191-95 SSO 1000 A S/1-3/4
BWPH 3 hr. #/4 BWPH 4 hr. SP 3184
20/3101-11 40/3111-21 SO & wtr.
1000 A S/1 BOPH 1 BW 3000 A
1 BOPH 3 1/2 BW P/19 BO 94 BW 15 hr.
Comp. 7 BOPD 26 BW

COMPLETED

Russell KANSAS

Section 24 Township 15 Range 13WWell No. #4 Piester "B"Company Kewanee Oil