

[illegible]

<u>Drlg. Data</u>	<u>Trapp Pool</u>
Location	

FABEN GILSTRAP

[illegible]

Drig. Data	D & A	TD 3362	Trapp Pool
8" @ 498	Anhy 820	Heeb. 2983	
Tor. 3000	Br. line 3068	Lans. 3080	
DST 3345-52	open 15 min.	Rec. 5' mud	
900#	Cong. 3338	DST 3350-62	open
1 hr.	Rec. 65' ocm	750#	Arb. 3343
TD 3362			

D & A

FABEN GILSTRAP

Russell KANSAS

SEC. 25 TWP. 15 R. 13W

WELL NO.

#1 Sellens

FARM

COMPANY

Jim Fleming

CONTRACTOR

Lewis Drlg. Tools Rlg 1


Trapp Pool

990 Ft. from N. Line

Ft. from S. Line

Ft. from E. Line

330 Ft. from W. Line

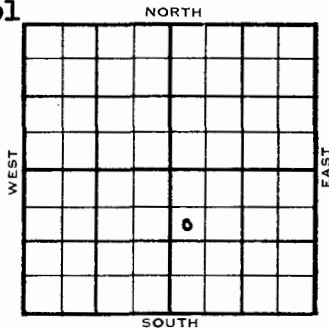

SW NW SE

ELEVATION	REPORT
1954	1885'

9/15 Location

9/29 Spud 9-15-54

D & A

TD 3362'

8" @ 498'

Anhy 820', Heeb 2983', Tor 3000', Br.

Lime 3068', Lans 3080',

DST 3345'-52' opn 15 min, rec 5' Mud

900# Cong 3338'

DST 3350'-62' opn 1 hr, rec 65' ocm,

750# Arb 3343'

TD 3362'

D & A

ABANDONED

DX-78

DX 78-1

Russell KANSAS

Section 25 Township 15 Range 13 W

Well No. # 1 Sellens

Company Jim Fleming

