

Map No. _____ Sec. 25 Twp. _____ R. _____

Well No. 6 Sellens

Sunray _____ Company

FIRST REPORT

Contractor

SW NW NW

SECTION PLAT

990 Ft. from N. Line

Ft. from S. Line

Ft. from E. Line

330 Ft. from W. Line

Russell County

Location

Rig up

Drilling and Remarks:

drlg. 425

RECORD

Cased _____ in. _____ ft.

Sand _____

Gas _____

Oil _____

Total Depth _____

PRODUCTION

1st 24 hrs. Nat. _____

1st 24 hrs. after shot _____

Gas _____ Cu. Ft.

Dry Hole _____

Abandoned _____

Date

DEC 1 1948 19 S. J. LEWIS Scout

Map No. 72 Sec. 25 Twp. 15 R. 13W

Well No. 6 Sellens

Sunray _____ Company

COMPLETE

Contractor

SW NW NW

SECTION PLAT

990 Ft. from N. Line

Ft. from S. Line

Ft. from E. Line

330 Ft. from W. Line

Russell County

Location

Rig up

Drilling and Remarks:

Art 3381

5" C 3382

Pump 294 oil 884

40 3 84

RECORD

Cased _____ in. _____ ft.

Sand _____

Gas _____

Oil _____

Total Depth 3342

PRODUCTION

1st 24 hrs. Nat. _____

1st 24 hrs. after shot _____

Gas _____ Cu. Ft.

Dry Hole _____

Abandoned _____

Date

JAN 5 1949 19 S. J. LEWIS Scout

KANSAS

Russell



Sec. 25 Twp. 15 R. 13W

Well No. #6 Sellens Farm

Sunray

Company

Trapp Pool


990' Ft. from N. Line

Ft. from S. Line

Ft. from E. Line

330' Ft. from W. Line

SW NW NW

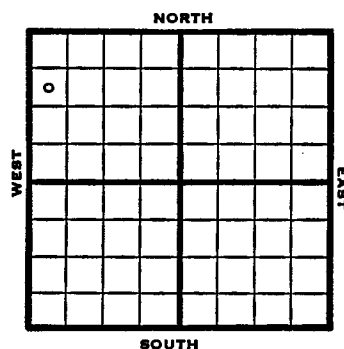


KANSAS Russell

Section 25 Township 15 Range 13-W

Well No. #6 Sellens

Company Sunray

Trapp

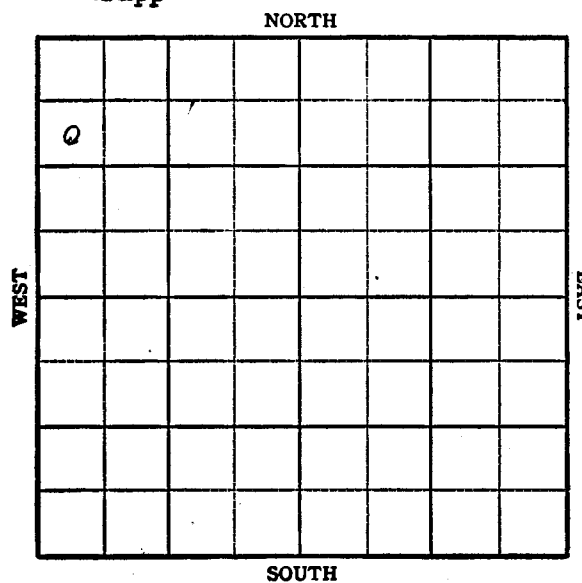

1948 Elev. 1874' REPORT

12/1 Drlg. 425'

12/8 8" @ 522'

Lansing 3067'

Drlg 3150'

12/15 Arb 3331-43'

TD 3343'

5" @ 3332'

12/22 Swb 6 bbls oil PH

12/29 Pump 180 bbls oil 13 hrs.

1949

1/5

Arb. 3331'

5" @ 3332'

Pump 284 oil P.O.T.

Gr. 40.9°

TD 3343'

COMPLETED