

Map No. _____ Sec. 25 Twp. 15 R. 13W

Well No. 4 Sellens

Sunray _____ Company

FIRST REPORT Contractor

NW SW


SECTION PLAT

330 Ft. from N. Line

Ft. from S. Line

Ft. from E. Line

330 Ft. from W. Line

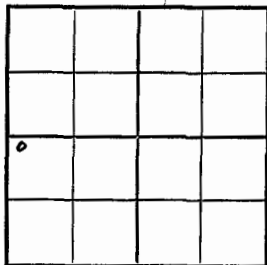

Russell County

Location _____

Rig up _____

Drilling and Remarks:

8" @ 567

drlg. 1221

RECORD

Cased _____ in., _____ ft.

Sand _____

Gas _____

Oil _____

Total Depth _____

PRODUCTION

1st 24 hrs. Nat. _____

1st 24 hrs. after shot _____

Gas _____ Cu. Ft.

Dry Hole _____

Abandoned _____

Date

APR 28 1948

19

S. J. LEWIS

Scout

Map No. 73 Sec. 25 Twp. 15 R. 13W

Well No. 4 Sellens

Sunray _____ Company

ABANDONED Contractor

NW SW


E11878
SECTION PLAT

330 Ft. from N. Line

Ft. from S. Line

Ft. from E. Line

330 Ft. from W. Line

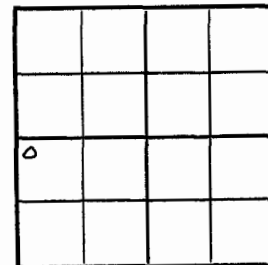

Russell County

Location _____

Rig up _____

Drilling and Remarks:

Lans 8067

Ct 48070

RECORD

Cased _____ in., _____ ft.

Sand _____

Gas _____

Oil _____

Total Depth 3570

PRODUCTION

1st 24 hrs. Nat. _____

1st 24 hrs. after shot _____

Gas _____ Cu. Ft.

Dry Hole _____

Abandoned _____

Date

MAY 5 1948

19

S. J. LEWIS

Scout

KANSAS Russell

Sec. 25 Twp. 15 R. 13W

Well No. #4 Sellens Farm

Sunray Company

Trapp


330 Ft. from N. Line

 Ft. from S. Line

 Ft. from E. Line

330 Ft. from W. Line

NW SW

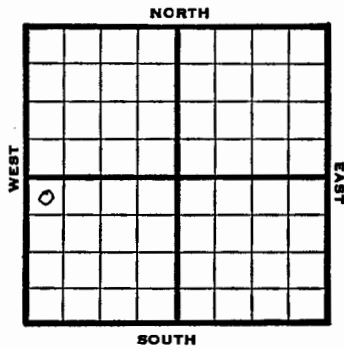

1948

Elev. 1873' REPORT

4/28

8" @ 567'

Drlg. 1221'

5/5

Lans. 3067'

Arbuckle 3370'

TD 3380'

ABANDONED

KANSAS

Russell

Section 25 Township 15 Range 13W

Well No. 4 Sellens

Company Sunray

