

Map No. _____ Sec. 25 Twp. 15 R. 13W

Well No. 4 Sellens

Phil-Han Company

FIRST REPORT Contractor

NW SE SW

SECTION PLAT

	o		

_____ Ft. from N. Line

990 Ft. from S. Line

990 Ft. from E. Line

_____ Ft. from W. Line

Russell County

Location _____

Rig up _____

Drilling and Remarks:

R U R

RECORD

Cased _____ in., _____ ft.

Sand _____

Gas _____

Oil _____

Total Depth _____

PRODUCTION

1st 24 hrs. Nat. _____

1st 24 hrs. after shot _____

Gas _____ Cu. Ft.

Dry Hole _____

Abandoned _____

Date

OCT 27 1948 19

S. J. LEWIS Scout

Map No. 13 Sec. 25 Twp. 15 R. 13W

Well No. 4 Sellens

Phil-Han Company

ABANDONED Contractor

NW SE SW

SECTION PLAT

	o		

_____ Ft. from N. Line

990 Ft. from S. Line

990 Ft. from E. Line

_____ Ft. from W. Line

Russell County

Location _____

Rig up _____

Drilling and Remarks:

Art 3325
5' 03327

RECORD

Cased _____ in., _____ ft.

Sand _____

Gas _____

Oil _____

Total Depth *3325*

PRODUCTION

1st 24 hrs. Nat. _____

1st 24 hrs. after shot _____

Gas _____ Cu. Ft.

Dry Hole _____

Abandoned _____

Date

DEC 1 1948 19

S. J. LEWIS Scout

KANSAS Russell

Sec. 25 Twp. 15 R. V13W

Well No. #4 Sellens Farm

Phil-Han Company


Trapp Pool

_____ Ft. from N. Line

990' Ft. from S. Line

990' Ft. from E. Line

_____ Ft. from W. Line

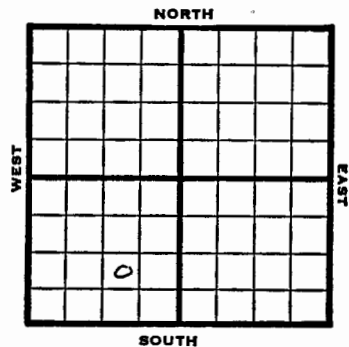

NW SE SW

1948	El ₁ 1871'	REPORT
10/27	RUR	
11/3	8" @ 480'	
	Drlg. 2420'	
11/10	Lansing 3058'	
	Arbuckle 3325'	
	TD 3328'	
	5" @ 3327'	
11/16	TD 3344'	
	400 acid	
11/23	"	
12/1	TD 3328'	
	Arb. 3325'	
	5" @ 3327'	
	Aband.	
	ABANDONED	

KANSAS Russell

Section 25 Township 15 Range 13W

Well No. 4 Sellens

Company Phil-Han

Trapp Pool

