

Trapp Pool

Map No. _____ Sec. 26 Twp. 15 R. 13W

Well No. 3 Letsch

Jones & Shelborne Company

Jones & Shelborne Contractor

SE NW SW


FIRST REPORT
SECTION PLAT

990 Ft. from N. Line

Ft. from S. Line

Ft. from E. Line

990 Ft. from W. Line

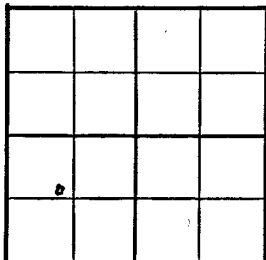

Russell County

Location X

Rig up

Drilling and Remarks:

RECORD

Cased in, ft.

Sand

Gas

Oil

Total Depth

PRODUCTION

1st 24 hrs. Nat.

1st 24 hrs. after shot

Gas Cu. Ft.

Dry Hole

Abandoned

Date

OCT 19 1955

19

S. J. LEWIS

Scout

Russell KANSAS

Sec. 26 Twp. 15 R. 13W

Well No. #3 Letsch Farm

Jones & Shelborne Company

Trapp Pool (Jones & Shelborne)


990' Ft. from N. Line

Ft. from S. Line

Ft. from E. Line

990' Ft. from W. Line

SE NW SW

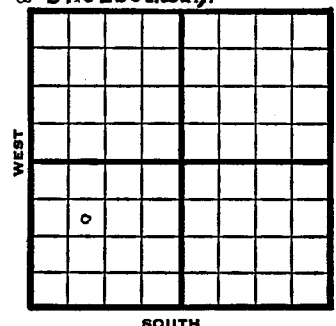

1949 Elev 1811' REPORT

10/19 Location
10/26 Rigging cable
11/1 12" @ 422'
Drlg. 685'
11/9 10" @ 795'
Drlg. 1615'
11/16 8" @ 2075'
Drlg. 2355'
11/23 Topeka 2697'
Drlg. 2900'
11/29 Lansing 3028'
7" @ 3032'
Drlg. 3180'
12/7 Arb. 3282' - 84'
TD 3284'
5" @ 3284'
12/14 "
12/21 "
12/28 "
1950
2/8 TD 3284'
10" @ 795'
8" @ 2075'
5" @ 3284'
Topeka 2697'
K C 3028'
Arb. 3282'
Set plug @ 3035'
Perf 96/3025-33
P 82 BOPD
4% wtr

COMPLETED

Map No. _____ Sec. 26 Twp. 15 R. 13WWell No. 3 LetschJones & Shelborne

Company

SE NW SW Contractor

E. 1811
SECTION PLAT990 Ft. from N. Line

Ft. from S. Line

Ft. from E. Line

990 Ft. from W. Line

COMPLETE			

Russell County

Location

Rig up

Drilling and Remarks:

10" @ 7958" @ 20755" @ 3284Log 2697K.C. 3028Ord 3282

(amr)

RECORD

Cased _____ in. _____ ft.

Sand

Gas

Oil

Total Depth 3284

PRODUCTION

1st 24 hrs. Nat.

1st 24 hrs. after shot

Gas _____ Cu. Ft.

Dry Hole

Abandoned

Date

FEB 8 1950

19

J. E. TYRA

Scout

Sept plug @ 3035
perf 96/3025-33P 82 BOPD4% wt.

Scout Cards	<u>Edith</u>
Land Small Map	
Land Wall Map	<u>3</u>
Tracings	
Fracture Map	
Flow Map	
Notes	

FEB 10 1950

KANSAS

Russell

Section 26 Township 15 Range 13WWell No. 3 LetschCompany Jones & ShelborneTrapp
NORTH