

County Russell State Kansas
 Sec. 26 (Bk. 16 (Sur. 13W Map No.
 (Twp.) (Rge.)
 Operator Sunray
 Well No. 5 Farm Rude
 Elev. _____ Location SW NW SE

990 Ft. From N Line SE
330 Ft. From W Line Quarter
 1st. Report AUG 30 1950
 Completion _____
 Remarks _____
 Spudding Date _____

Drig. Data Trapp PoolM I R

J. E. TYRA

County Russell State Kansas
 Sec. 26 (Bk. 15 (Sur. 13W Map No.
 (Twp.) (Rge.)
 Operator Sunray
 Well No. 5 Farm Rude
 Elev. 1875 Location SW NW SE

990 Ft. From N Line SE
330 Ft. From W Line Quarter
 1st. Report _____
 Completion OCT 18 1950
 Remarks Trapp Pool
Stickle Drlg. - Contr.
 Spudding Date 8-31-50

Drig. Data Oil well TD 33608" @ 536 Top. 2743 Heeb. 2973Br. lime 3052 Lans. 3064 Cong. 3304Arb. 3332 5" @ 3334 TD 3354S/ 30 go 30 gw DD 3360 1000 A10 bo 9 bwpd Comp. 48 bopd 44 bw

J. E. TYRA

Russell KANSAS

Sec. 26 Twp. 15 R. 13W

Well No. #5 Rude Farm

Sunray Company

Stickler Drlg. - Contr Contractor

Trapp Pool


990' Ft. from N. Line

Ft. from S. Line

Ft. from E. Line

330' Ft. from W. Line

SW NW SE

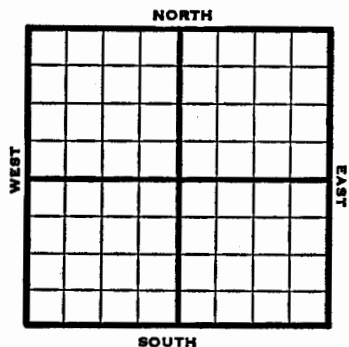


Russell KANSAS

Section 26 Township 15 Range 13W

Well No. #5 Rude

Company Sunray

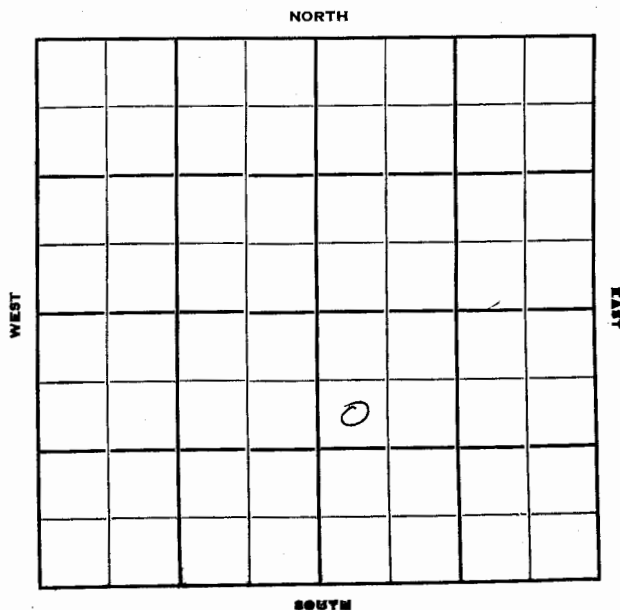

1950 Elev. 1875' REPORT

8/30 MIR

10/18 Spud 8-31-50
Oil Well TD 3360'
8" @ 536' Top 2743' Heeb 2973'
Br Line 3052' Lans. 3064'
Cong. 3304' Arb. 3332'
5" @ 3334' TD 3354'
S/30 GO 30 GW DD 3360
1000 A 10 BO 9 BWPD
Comp. 48 BOPD 44 BW

COMPLETED