

Map No. _____ Sec. 26 Twp. 15 R. 13W

Well No. 3 Rube

Sunray _____ Company

REPORT _____ Contractor

NE NW SE


SECTION PLAT

330 _____ Ft. from N. Line

_____ Ft. from S. Line

_____ Ft. from E. Line

990 _____ Ft. from W. Line

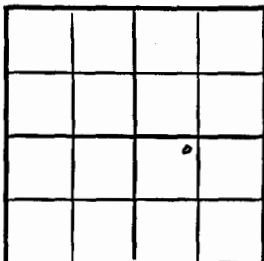

Russell County

Location _____

Rig up _____

Drilling and Remarks:

8" @ 521

RECORD

Cased _____ in., _____ ft.

Sand _____

Gas _____

Oil _____

Total Depth _____

PRODUCTION

1st 24 hrs. Nat. _____

1st 24 hrs. after shot _____

Gas _____ Cu. Ft.

Dry Hole _____

Abandoned _____

Date _____

JAN 19 1949

19

S. J. LEWIS

Scout

Map No. 73 Sec. 26 Twp. 15 R. 13W

Well No. 3 Rube

Sunray _____ Company

COMPLETE _____ Contractor

NE NW SE


SECTION PLAT

330 _____ Ft. from N. Line

_____ Ft. from S. Line

_____ Ft. from E. Line

990 _____ Ft. from W. Line

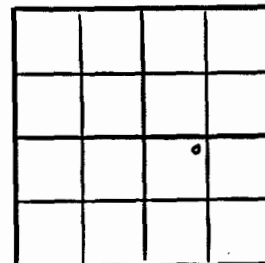

Russell County

Location _____

Rig up _____

Drilling and Remarks:

Cased 521

5" @ 336

700 Rube

Pump 18 ft. Rube

40 9/16

RECORD

Cased _____ in., _____ ft.

Sand _____

Gas _____

Oil _____

Total Depth 336

PRODUCTION

1st 24 hrs. Nat. _____

1st 24 hrs. after shot _____

Gas _____ Cu. Ft.

Dry Hole _____

Abandoned _____

Date _____

MAR 16 1949

19

S. J. LEWIS

Scout

Russell

KANSAS

Sec. 26 Twp. 15 R. 13W

Well No. #3 Rube Farm

Sunray

Company

Trapp Pool


330' Ft. from N. Line

Ft. from S. Line

Ft. from E. Line

990' Ft. from W. Line

NE NW SE

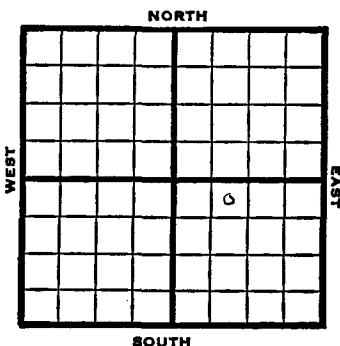

1949 lev 1875' REPORT

1/19 8" @ 521'
1/26 Lansing 3070'
Drlg 3103'
2/2 Arbuckle 3335'
TD 3337'
5" @ 3336'
2/9 3359- 750 acid
Bail 1/2 bbls oil PH
2/16 250 acid
Bail 1 bbl oil PH
2/23 "
3/2 "
3/8 "
3/16 TD 3359'
Arb. 3335'
5" @ 3336'
750 acid
Pump 18 oil Pot
409 Gr.
Comp
COMPLETED

KANSAS

Russell

Section 26 Township 15 Range 13W

Well No. 3 Rube

Company Sunray

Trapp

NORTH

