

Map No. KANSAS Sec. 26 Twp. 15 R. 13 W

Well No. 73 2 Hafferman

Prairie Oil & Gas Company

Contractor

SECTION PLAT

		o	

330 Ft. from N. Line

..... Ft. from S. Line

..... Ft. from E. Line

330 Ft. from W. Line

FIRST REPORTS

Location

Rig up

Drilling and Remarks:

RECORD

Cased.....in.,ft.

Sand.....

Gas.....

Oil.....

Total Depth.....

PRODUCTION

1st 24 hrs. Nat.....

1st 24 hrs. after shot.....

Gas..... Cu. Ft.

Dry Hole.....

Abandoned.....

Date

DEC 10 1930 S. J. LEWIS Scout

Map No. KANSAS Sec. 26 Twp. 15 R. 13 W

Well No. 73 Wanta Rude

Prairie Oil & Gas Company

Contractor

SECTION PLAT

		o	

330 Ft. from N. Line

..... Ft. from S. Line

..... Ft. from E. Line

330 Ft. from W. Line

CORRECTION

Location.....

Rig up.....

Drilling and Remarks:

*Reported as
No 2 Hafferman*

RECORD

Cased.....in.,ft.

Sand.....

Gas.....

Oil.....

Total Depth.....

PRODUCTION

1st 24 hrs. Nat.....

1st 24 hrs. after shot.....

Gas..... Cu. Ft.

Dry Hole.....


Abandoned.....

Date

JAN 14 1931 S. J. LEWIS Scout

Russell
Map No. **KANSAS** Sec. **26** Twp. **15** R. **13W**
Well No. **73** *Kate Rude*
Prairie Oil & Slick Company
Contractor

SECTION PLAT

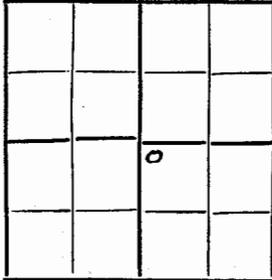

220 Ft. from N. Line
..... Ft. from S. Line
..... Ft. from E. Line
220 Ft. from W. Line

COMPLETED

Location.....
Rig up..... *Silco* *3326-46*
Drilling and Remarks:


RECORD
Cased..... in., ft.
Gas.....
Oil.....
Total Depth *3346*

PRODUCTION
1st 24 hrs. Nat.....
1st 24 hrs. after shot.....
Gas..... Cu. Ft.
Dry Hole.....
Abandoned.....

Date
FFR 11 1931
192..... *S. J. LEWIS* Scout

Map No. **KANSAS** Sec. **26** Twp. **15** R. **13W**
Well No. ~~1-*[scribble]*~~ *Kate Rude*
Prairie & Slick Farm
Company

330 Ft. from N. Line
..... Ft. from S. Line
..... Ft. from E. Line
330 Ft. from W. Line

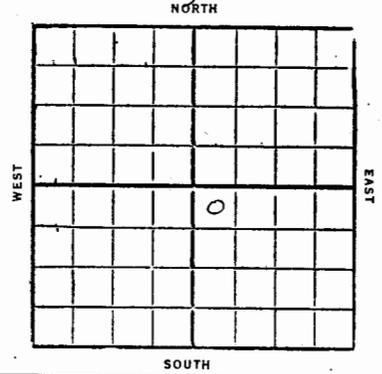

Date	REPORT
<i>12/10</i>	<i>Loc</i>
<i>12/17</i>	<i>Blky Rig</i>
<i>12/23</i>	<i>Rig up</i>
<i>12/30</i>	<i>Spud</i>
<i>1/3</i>	
<i>1/7</i>	<i>15"-457</i>
<i>1/14</i>	<i>Dry 900</i>
<i>1/21</i>	<i>" 1750'</i>
<i>1/28</i>	<i>" 2465</i>
<i>2/4</i>	<i>" 2830'</i>
	<i>show oil & water 3140-60</i>
	<i>5"-3318</i>
	<i>Silco line 3326-46</i>
	<i>Drly ahead</i>
<i>2/11</i>	<i>Silco line 3326-46</i>
	<i>T.D. 3346</i>
	<i>swab 410 bbl oil</i>
	<i>Comp.</i>

